

WPX Energy Rocky Mtn LLC

FINAL

**RWF 511-32**


API #05-045-21052-00

1082' FNL x 1330' FWL - SHL - (NENW)

176' FNL x 382' FWL - BHL - (NWNW)

Sec. 32-T6S-R94W

Garfield County, Colorado

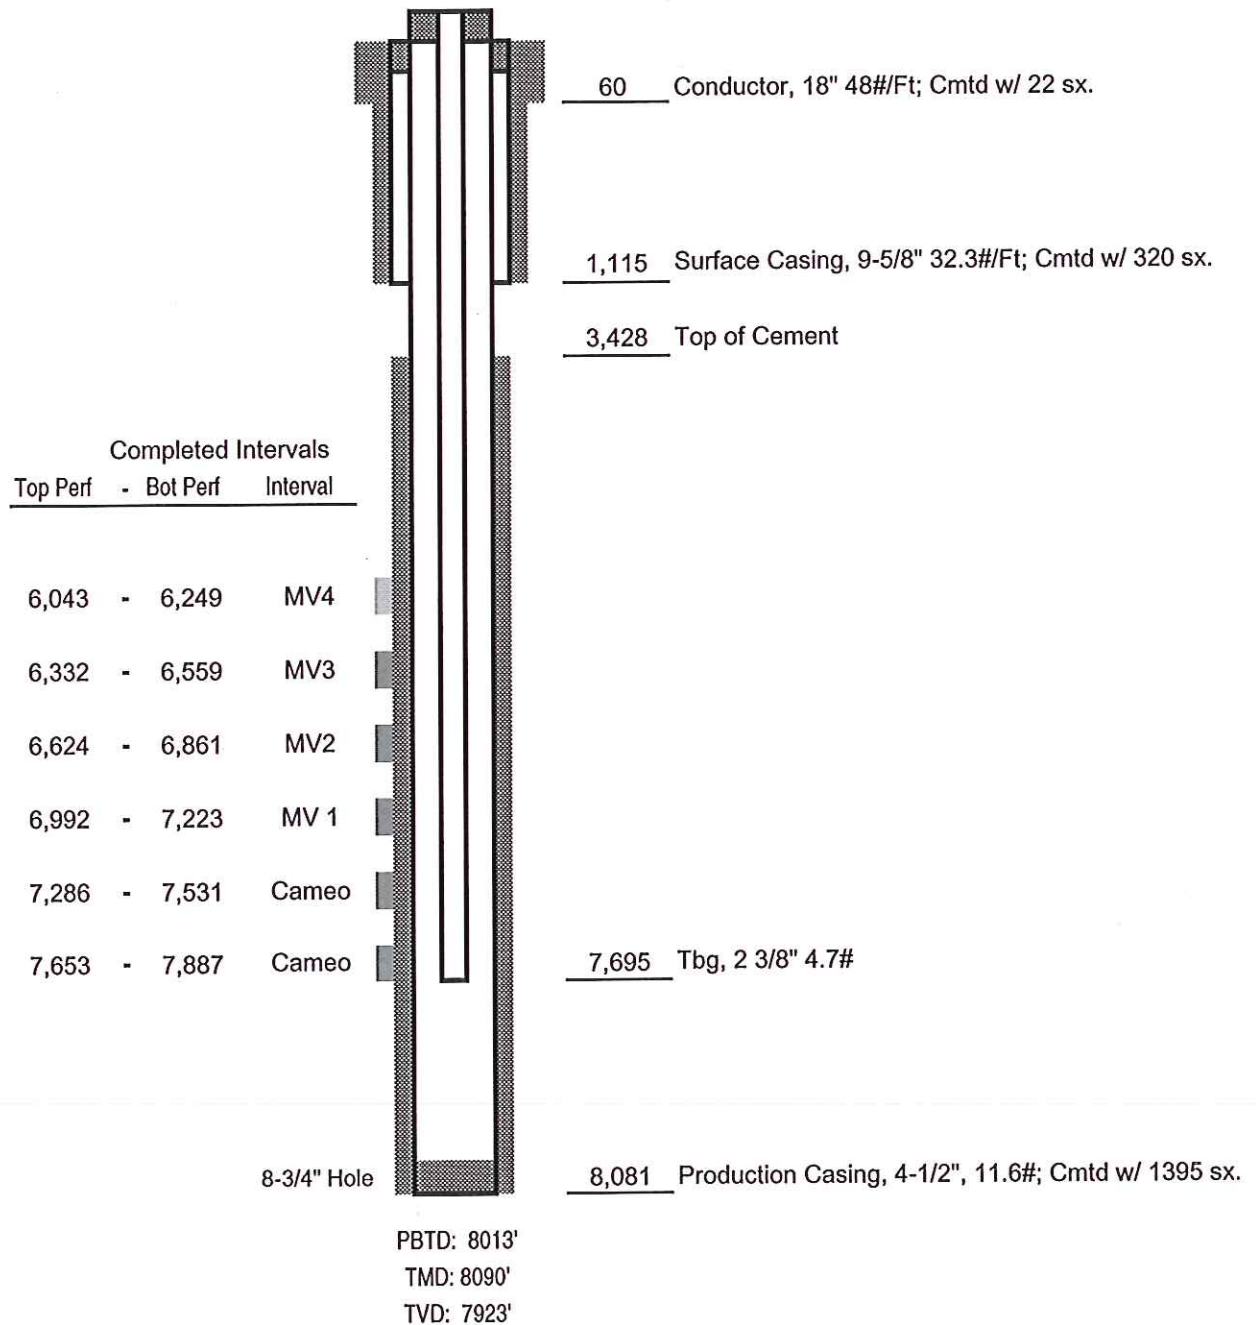

Not to Scale