

WPX Energy Rocky Mtn LLC

FINAL

RWF 322-32


API #05-045-21046-00

1086' FNL x 1355' FWL - SHL - (NENW)

1726' FNL x 1747' FWL - BHL - (SENW)

Sec. 32-T6S-R94W

Garfield County, Colorado

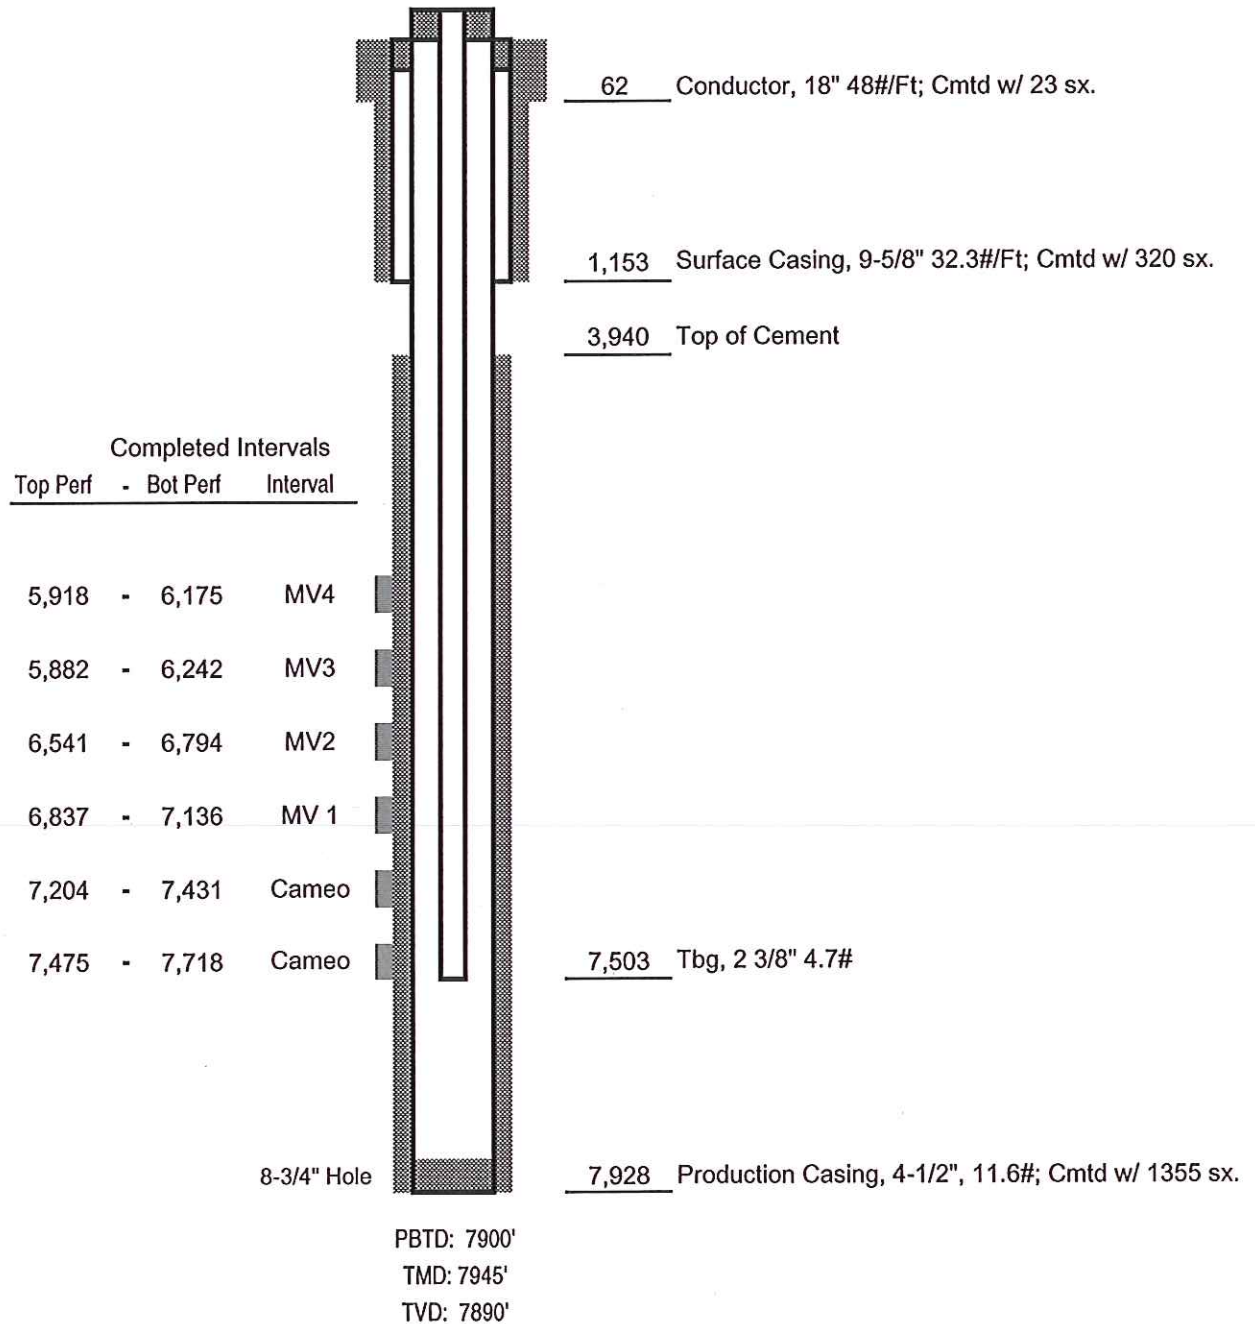

Not to Scale