Bonanza Creek Energy Operating Company, LLC
Antelope B-20
Codell/Niobrara
Frac Report

Well Name: Antelope B-20
County/State: Weld County, CO
SH Loc: 501' FNL & 711' FWL, NWNW Sec 20, T5N, R62W
BHL Loc: 1250' FNL & 50' FWL, NWNW Sec 20, T5N, R62W
API# 05-123-34912
AFE# 12025

Updated as of 4/19/2012

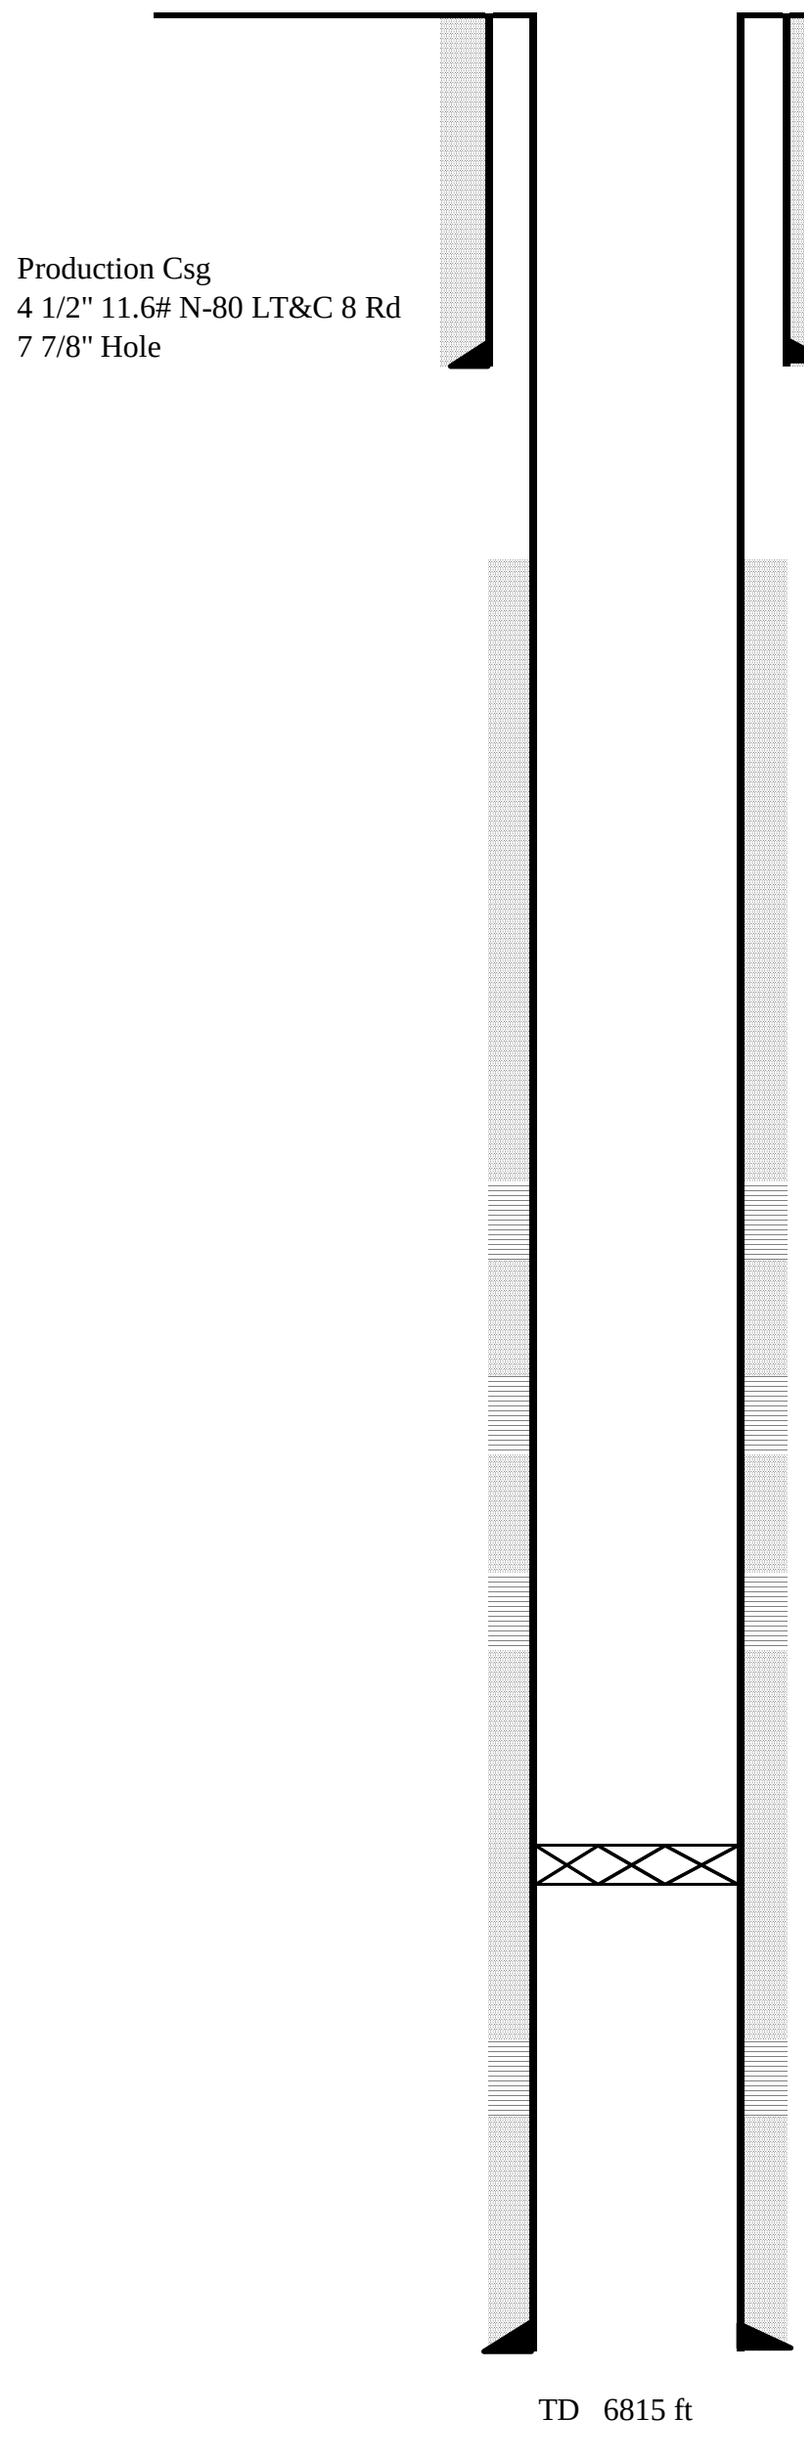

Niobrara Mid Perf
6496 ft

Niobrara - A Bench
6422 ft
6428 ft — 6 ft
2 spf (0.40" Dia) — 12 Holes

Niobrara - B Bench
6498 ft
6510 ft — 12 ft
2 spf (0.40" Dia) — 24 Holes

Niobrara - C Bench
6564 ft
6570 ft — 6 ft
2 spf (0.40" Dia) — 12 Holes

48 Total Holes
120° phasing

4 1/2" Obsidian FTFP
6624 ft

Codell Mid Perf
6674 ft

Codell Perfs
6670 ft — 8 ft
6678 ft — 32 Holes
4 spf (0.40" Dia) — 60° phasing

PBTD
6775 ft

Csg Landed
6790 ft