




02518049

# DOWLER #1

SECTION 13, T34N-R9W  
LA PLATA COUNTY, COLORADO

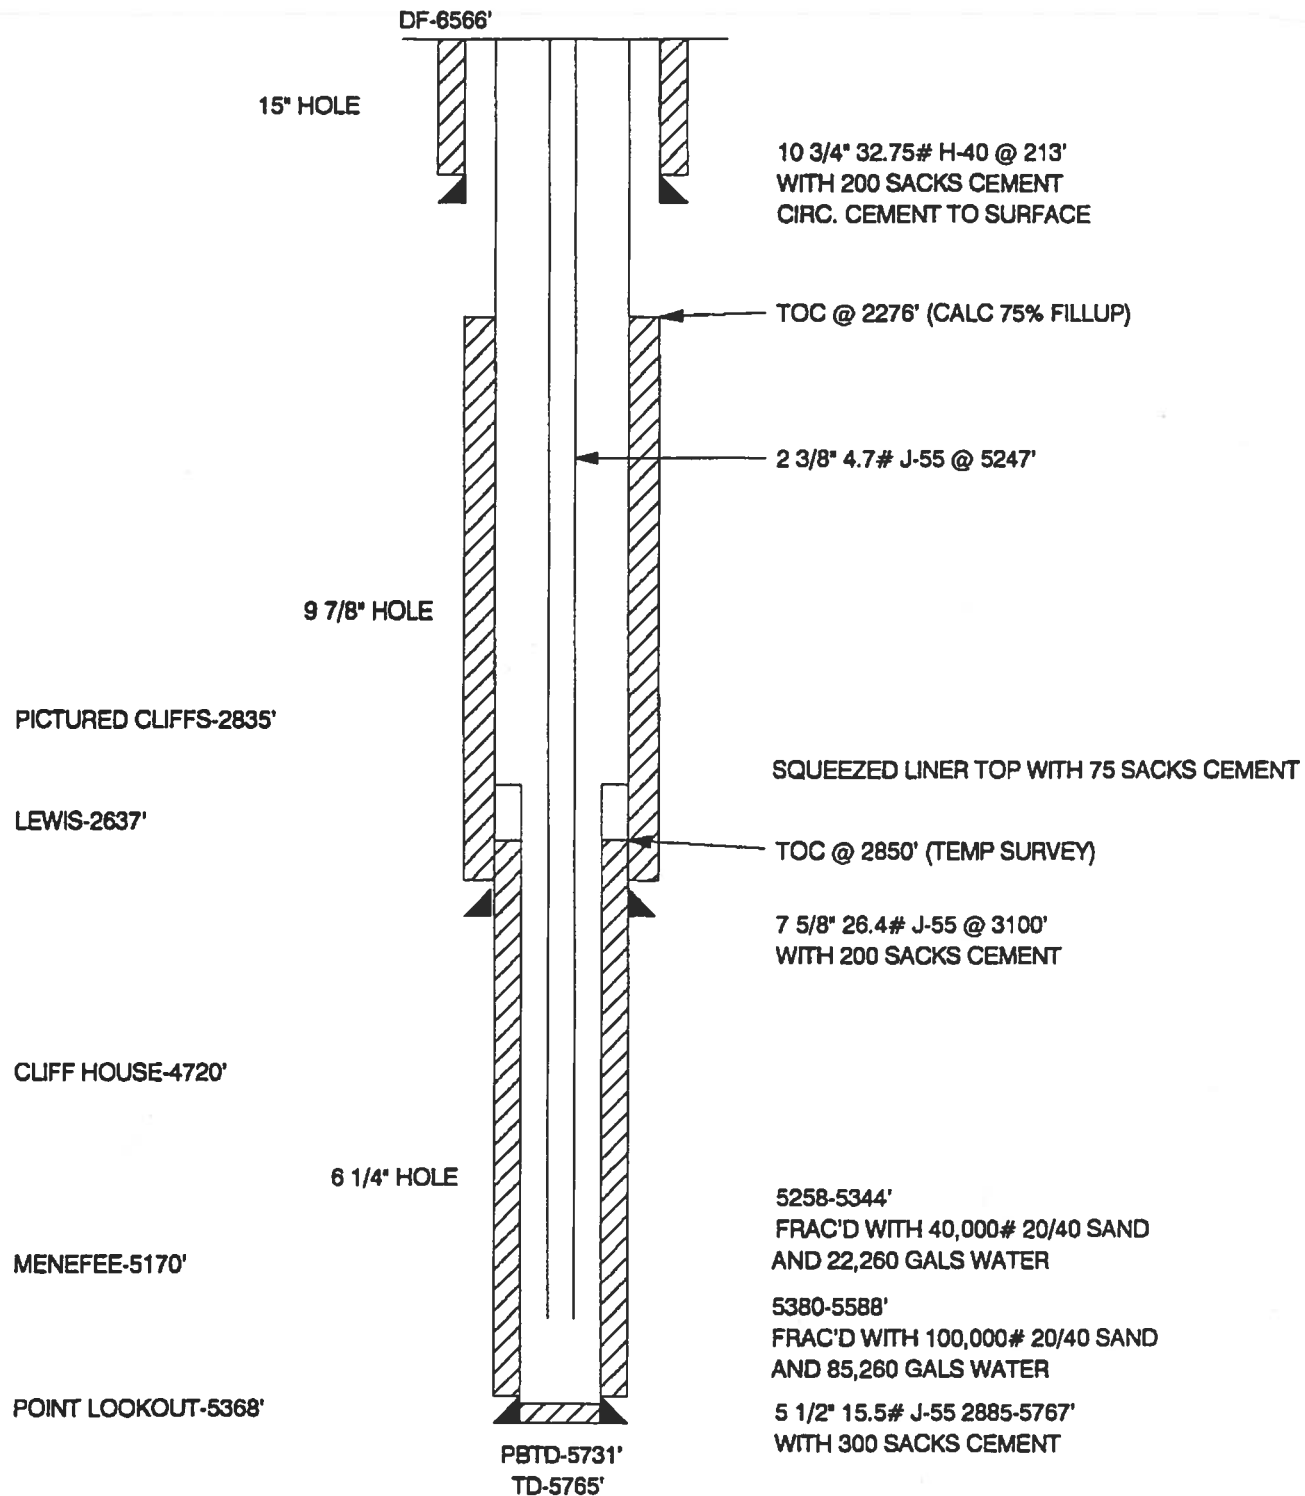

3/26/91 JLS