

WPX Energy Rocky Mountain, LLC
Federal RG 414-14-298
Sulphur Creek Field
SHL 276' FSL 1975' FWL (SE/4 SW/4) BHL 381' FSL 623' FWL (SW/4 SW/4)
Section 14-T2S-R98W 6th PM
Garfield County, Colorado

Formation Tops
(Measured Depths)

Mesaverde @ 6362'

Cameo @ 9227'


Rollins @ 9814'

Cozzette @ 9937'

Corcoran @ 10157'

Sego @ 10507'

PBTD @ 10746'
TMD @ 10956'
TVD @ 10782'

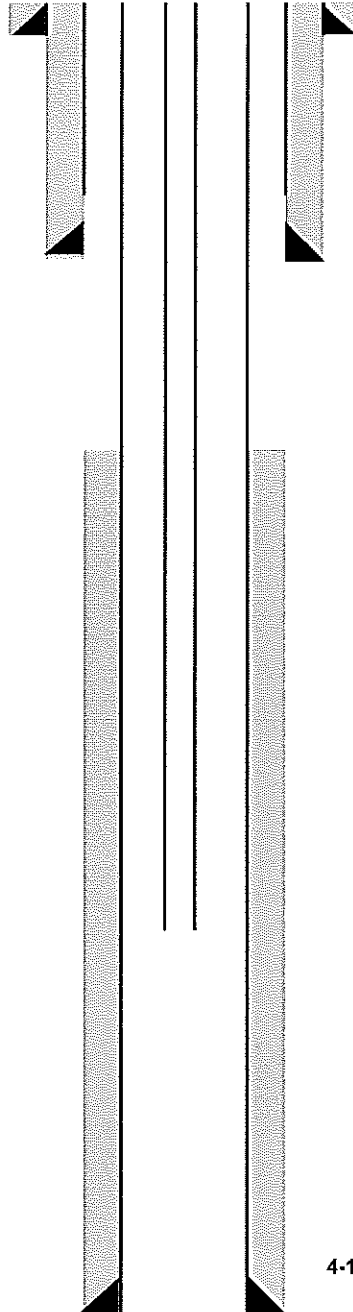

Conductor 30" Hole 18" casing/liner 80' W/135 sks cmt

Cmt @ Surface - (Cmt circ to surf during cmt job)

9 5/8" 36# ppf Csg. Set @ 3380'
 In 14 3/4" Hole W/1555 Sks. Cmt

Top Of Cement 4067'

8335-8488	Mesaverde
8525-8807	Mesaverde
9025-9224	Mesaverde
9354-9502	Cameo
9550-9738	Cameo
10135-10137	Cozzette
10192-10244'	Corcoran
10298-10502'	Corcoran
10517-10636	Sego
10664-10807	Sego

4-1/2", 11.6 ppf. Csg. Set @ 10943' W/ 1555 sks Cmt