

WPX Energy Rocky Mtn LLC

FINAL

**RWF 41-31**

API #05-045-21049-00


1084' FNL x 1323' FWL - SHL - (NWNW)

Sec. 32-T6S-R94W

178' FNL x 626' FEL - BHL - (NENE)

Sec. 31-T6S-R94W

Garfield County, Colorado

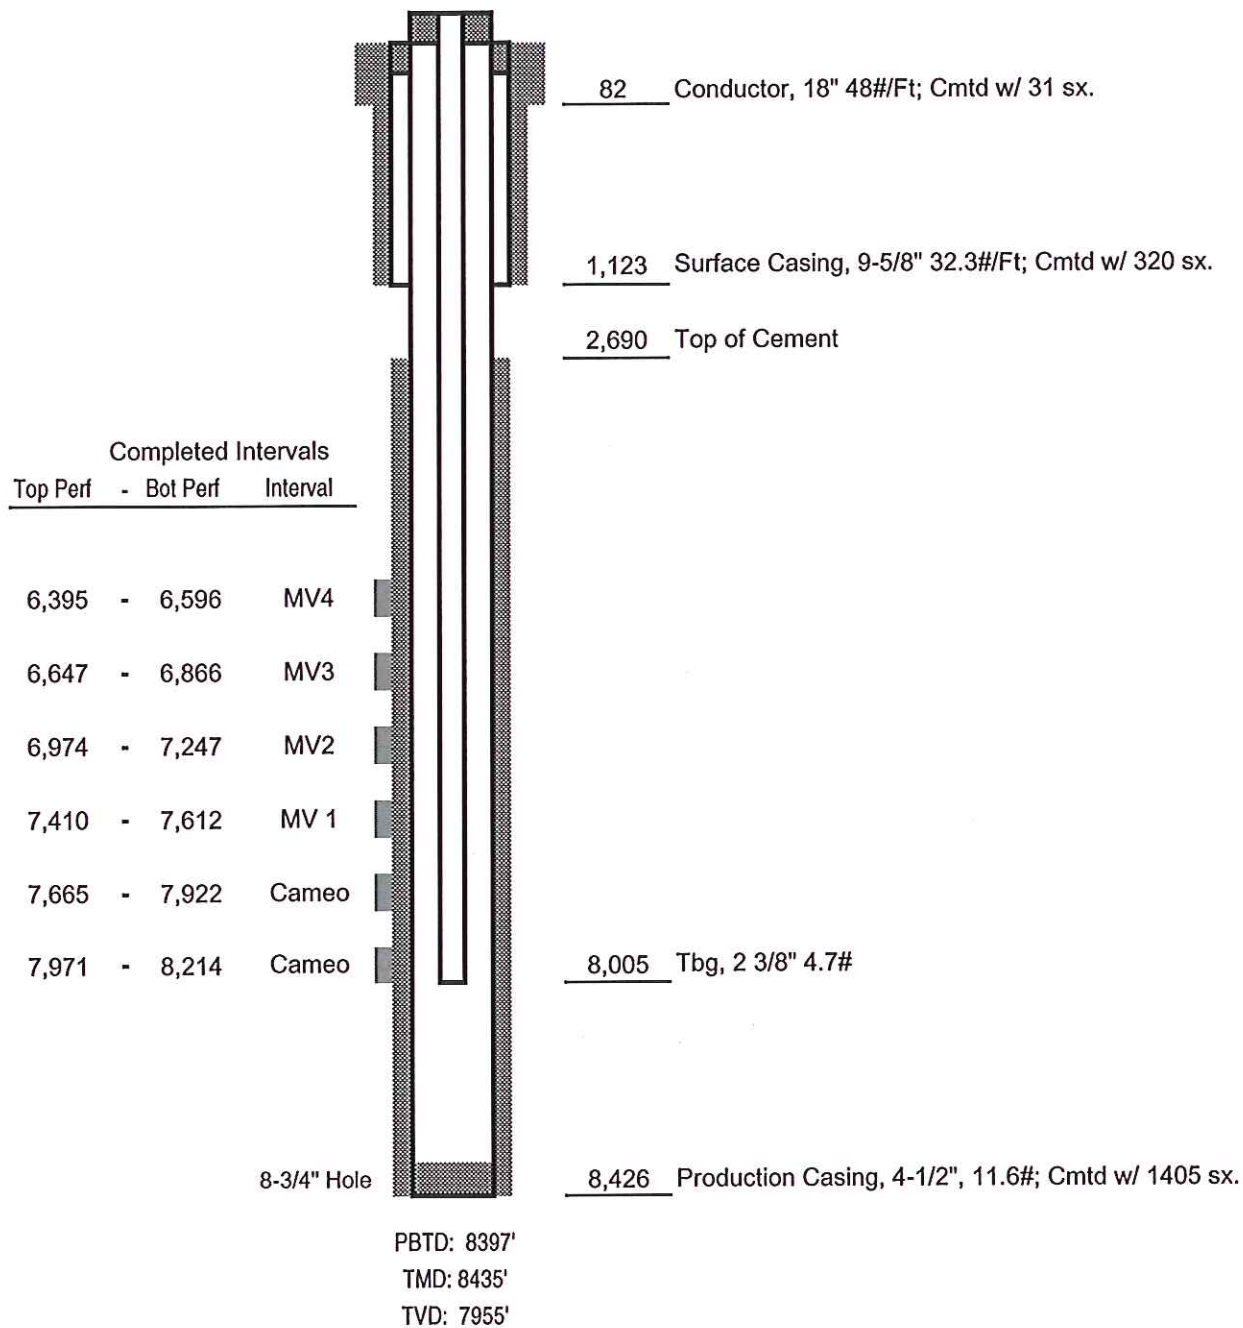

Not to Scale