

OXY USA INC.

Downhole Schematic


Well Name: Sniff B-1 API: 05-011-06036

DATE: 11/03/2012 **AUTHOR:** D.Berg/K. Andrews

LOCATION: 2310' FNL & 2310' FWL of Section 9 Township 23S Range 48W, Bent Co., Colorado

GL: 3788'

KB: 3797'

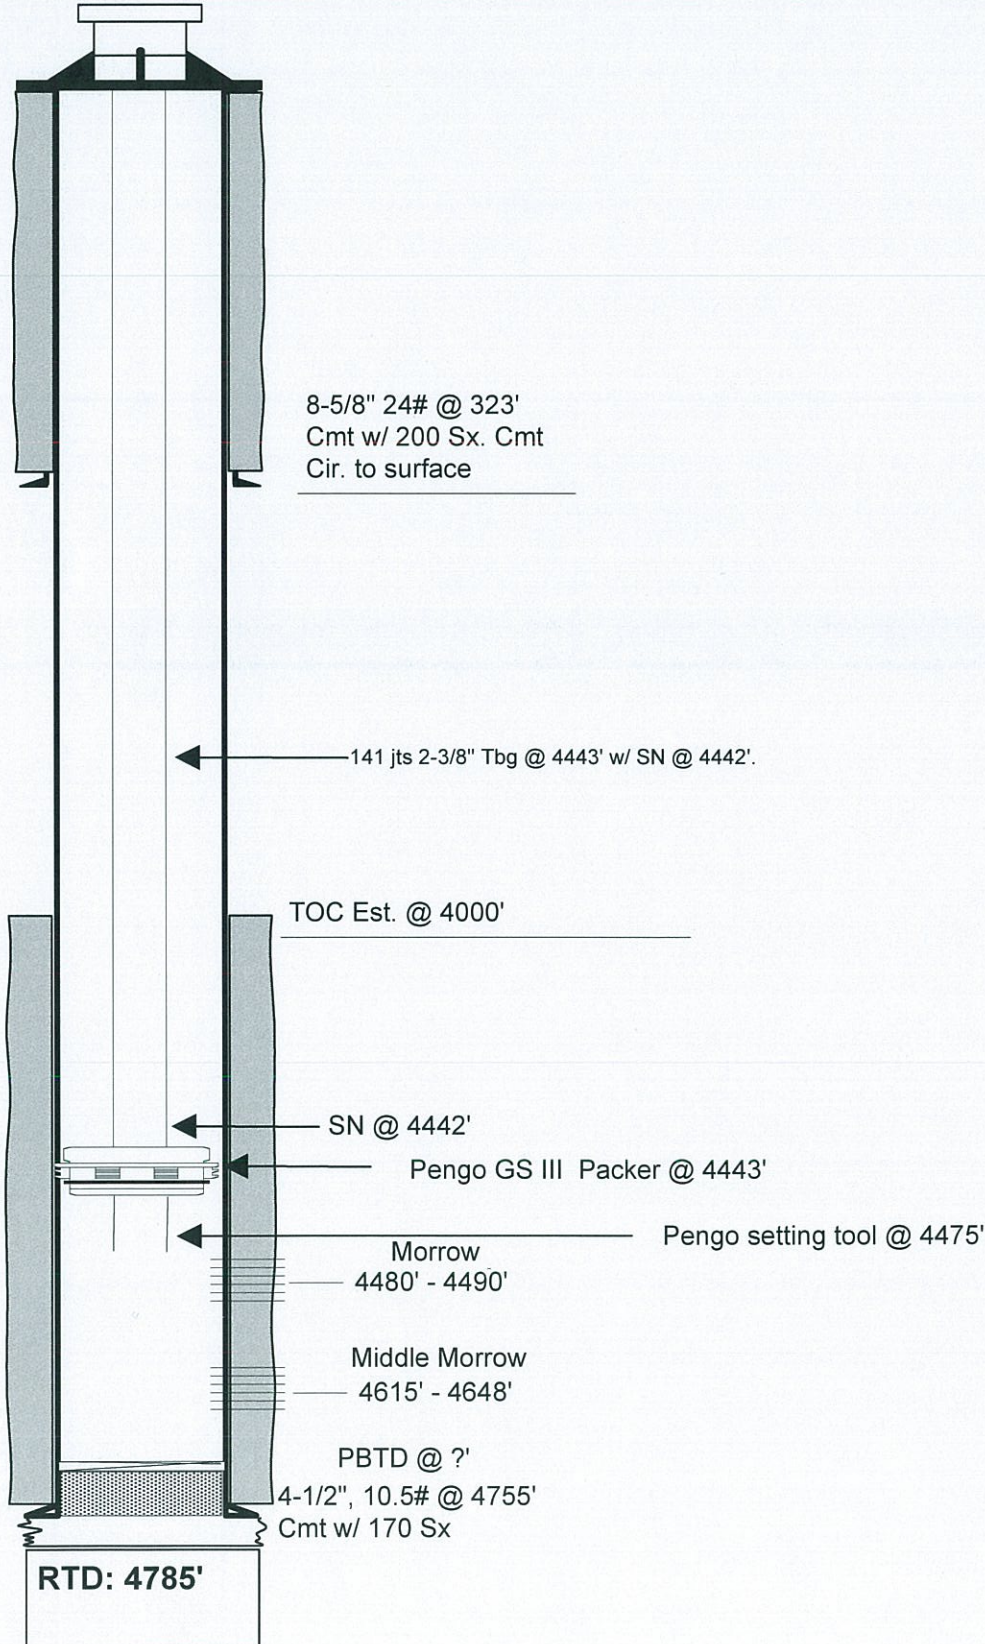

Notes:

Stone Corral: 1644'. Suspect hole in tbg @ unknown depth. Suspect hole in csg @ unknown depth.

CURRENT COMPLETION