

Levely 100 Lateral detail
 API - 06-067-08759 01, 02 & 03
 Basin Fruitland Coal
 SENW, Sec. 13, T32N, R7W

| Lateral number | Perfd Liner Section Production Interval | MD Total Depth | VD Total Depth | Cement |
|----------------|--|-------------------|-------------------|--------|
| | | | | |
| 01 | n/a (abandoned) | 3880' | 2992' | n/a |
| 02 03 | 3131' - 3948' | 4030' | 2946' | none |
| 03 02 | 2806' - 3502' | 3598' | 2830' | none |

FWL

Liner Detail

| Liner Detail | Window to Lateral | TOL | Liner Setting Depth |
|--------------|-------------------|-------|---------------------|
| 01 | 2628' - 2641' | n/a | n/a |
| 02 03 | same as 01 | 2621' | 3992' |
| 03 02 | 2498' - 2512' | 2491' | 3544' |

Lateral Location Footages at Producing Interval

| | Start | End | TD Footages of Lateral |
|---------|-----------------------|----------------------|---|
| 01 | n/a | 745' FNL & 759' VW | 791' FNL & 811' FWL, Sec. 13, T32N, R7W |
| 02 03 * | 1216' FNL & 1256' FWL | 745' FNL & 759' FWL | 690' FNL & 699' FWL, Sec. 13, T32N, R7W |
| 03 03 | 1445' FNL & 1501' FWL | 953' FNL & 1029' FWL | 888' FNL & 958' FWL, Sec. 13, T32N, R7W |

* Note: The production interval of "02" includes the upper portion of "01"s hole

Stimulation

Neither Lateral was stimulated

Levey 100 Laterals

The original wellbore was completed in 2002. Have finished adding laterals
Direction survey for 01, 02, & 03 laterals attached
API - 05-067-08759, 01, 02 and 03
SENW, Sec. 13, T32N, R7W

GL - 6392'
KB - 6404'

State of Colorado, La Plata Co.

Surface Location: 02
Lateral 03, beginning of Production Interval
Lateral B, end of Production Interval
TD footages


1546' FNL & 1586' FWL, Sec. 13, T32N, R7W
1445' FNL & 1501' FWL, Sec. 13, T32N, R7W
953' FNL & 1029' FWL, Sec. 13, T32N, R7W
888' FNL & 958' FWL, Sec. 13, T32N, R7W

Lateral 02, beginning of Production Interval
Lateral 2, end of Production Interval
TD footages

1216' FNL & 1256' FWL, Sec. 13, T32N, R7W
745' FNL & 759' FWL, Sec. 13, T32N, R7W
690' FNL & 699' FWL, Sec. 13, T32N, R7W

Lateral 01, beginning of Production Interval
Lateral 01, TD footages

N/A - uppermost portion of 01 is included in Lateral 02
791' FNL & 811' FWL, Sec. 13, T32N, R7W

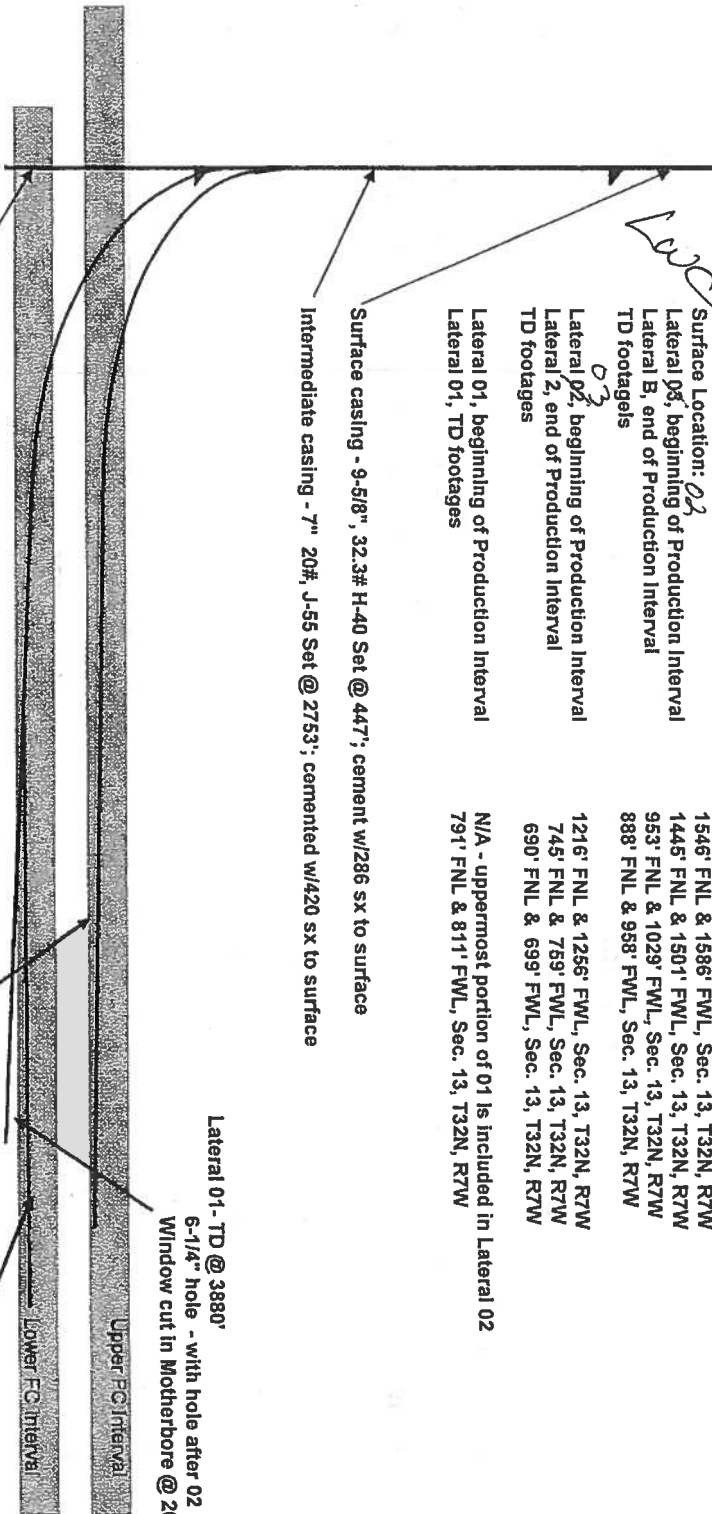

Surface casing - 9-5/8", 32.3# H-40 Set @ 447'; cement w/286 sx to surface
Intermediate casing - 7" 20#, J-55 Set @ 2753'; cemented w/420 sx to surface

Production Liner for Motherbore - 5-1/2", 15.5#, J-55 set @ 2722' - 2984'
Uncemented liner

Lateral 01- TD @ 3880'
6-1/4" hole - with hole after 02 lined abandoned
Window cut in Motherbore @ 2628' - 2641'

Lateral 02 - TD @ 4030' w/VD @ 2946'
6-1/4" hole w/4-1/2" liner 11.6#/ft, L-80 BTC
TOL @ 2621' Landed @ 3992'
Perf'd Liner Section of Liner from 3131' - 3948'
Window cut in Motherbore @ 2628' - 2641'

Lateral 03 TD @ 3598' w/VD @ 2830'
6-1/4" hole w/4-1/2" liner 11.6#/ft L-80 BTC
TOL @ 2491' landed @ 3544'
Perf'd liner section of liner from 2806' - 3502'
Window cut in Motherbore @ 2498' - 2512'