



Physical Address: 345 Comanche St.
Mail to: Box 384 Kiowa, CO 80117
Ph. 303-621-8672 - Fax 303-621-2717
www.highprairiesurvey.com

Job # 08193 Sentinel #1


Inv # 2111

High Prairie Surveying of Kiowa, Colorado has in accordance with a request from **Bayhorse Petroleum** has determined the location of **Sentinel # 1** to be 1750 feet FNL, and 2140 feet FWL, (90° off Section lines) of SECTION **31**, Township **20s**, Range **45w** of the 6th Principal Meridian, **Kiowa County**, Colorado.

Date: Staked on 9/27/12 drawn on 10/01/12.

Re: Staked by Keith Westfall
Drawn: Drawn by Dustin Cotter

Reference Area

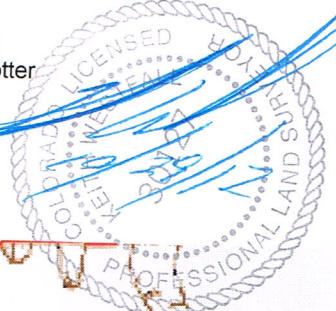

REFERENCE AREA
LAT 38.27849 (decimal degrees)
LONG 102.50684 (decimal degrees)



BAYHORSE PETROLEUM
NW 1/4 SEC. 31-20S-45W
SENTINEL #1
KIOWA, Co. COLORADO

x 3724

31