Well Name:	Federal 13A-34-691	BILL BARRETT CORPORATION
SHL:	SESE, Sec. 33, T6S-R91W, 6th PM	date updated 11/13/2012
		updated by Julie Webb
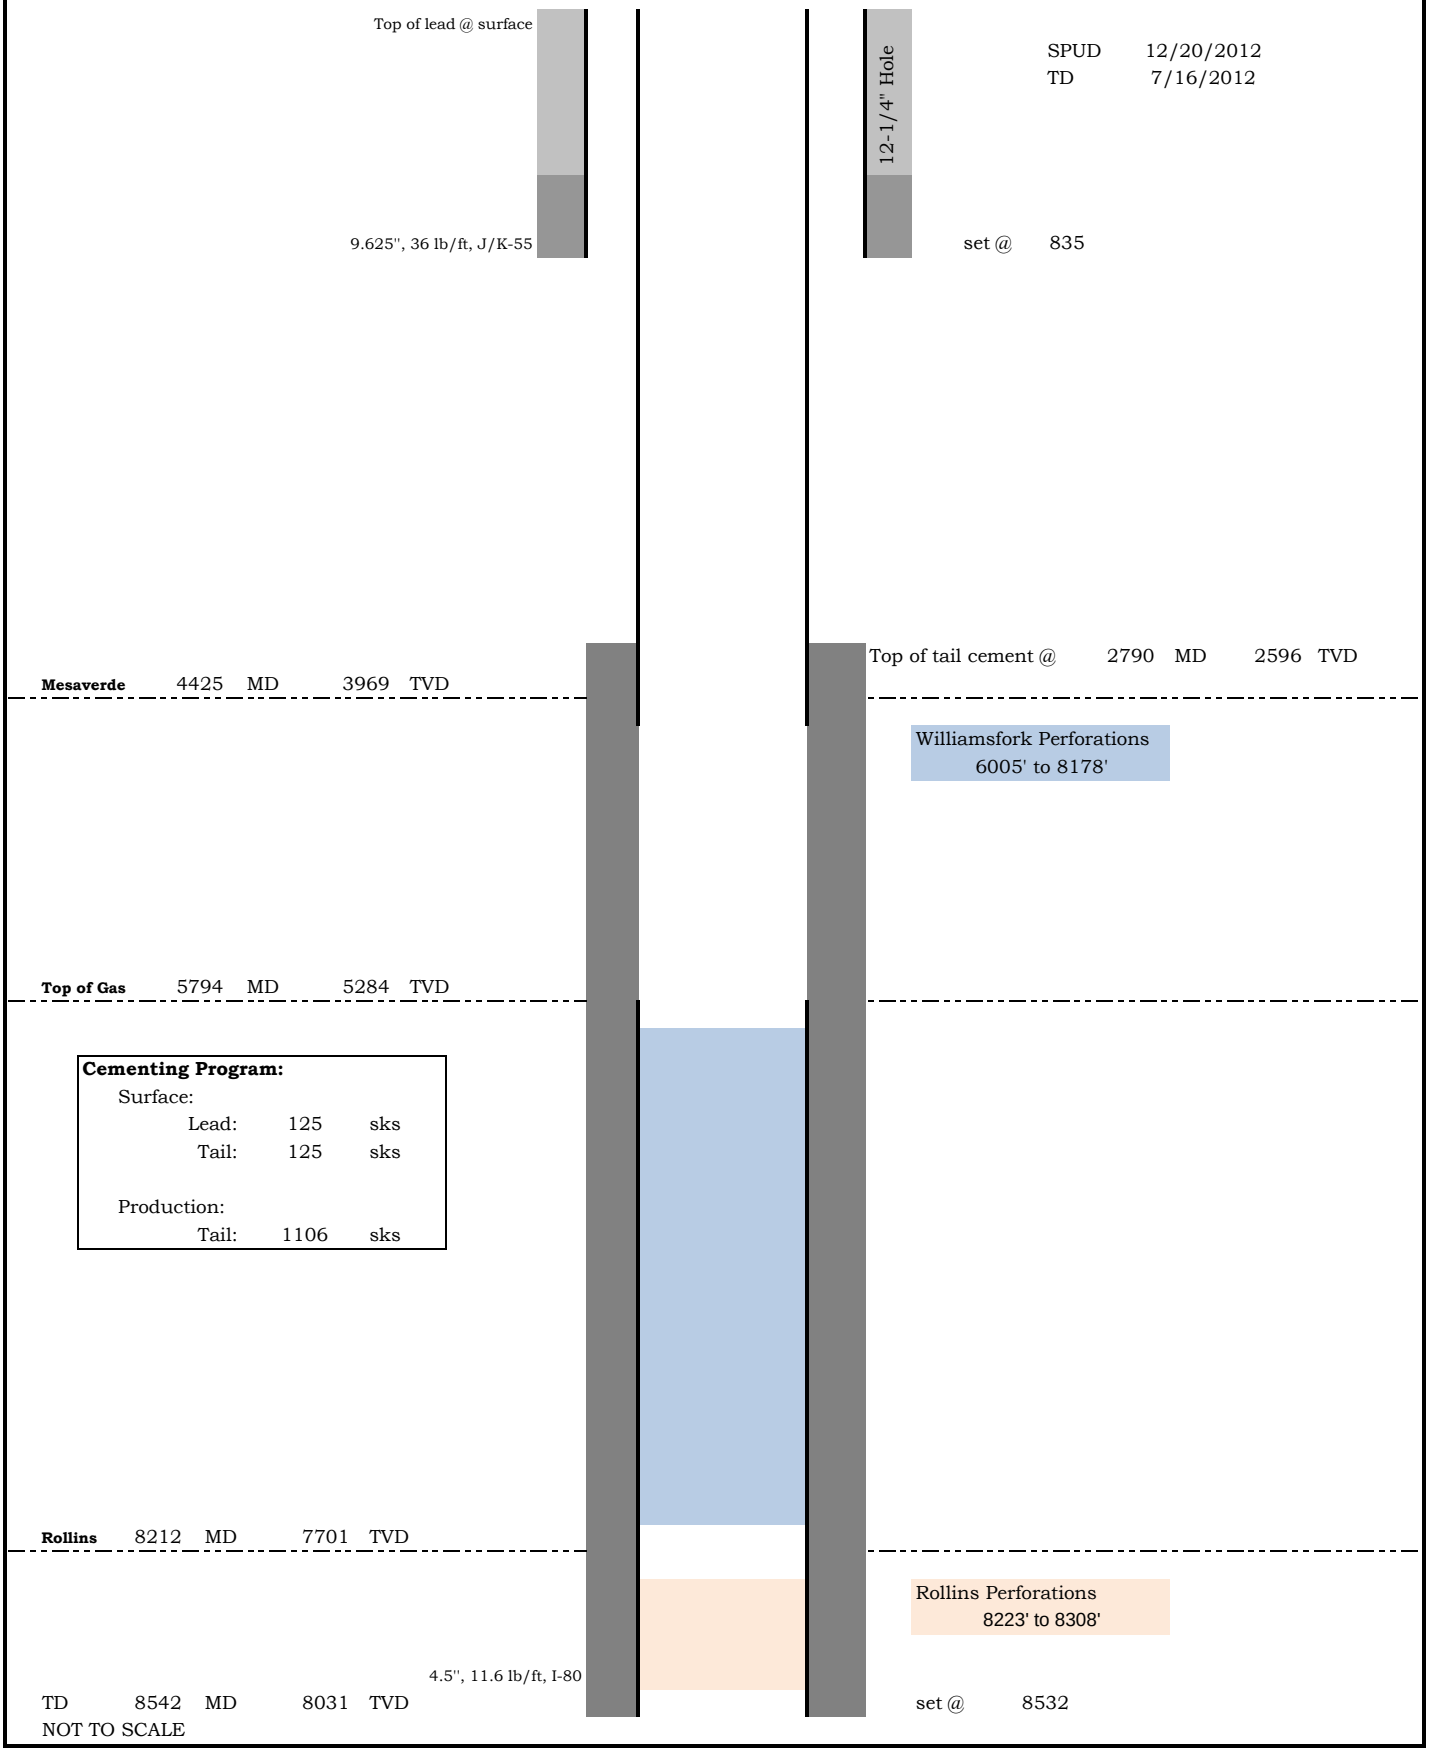
05-045-20865