
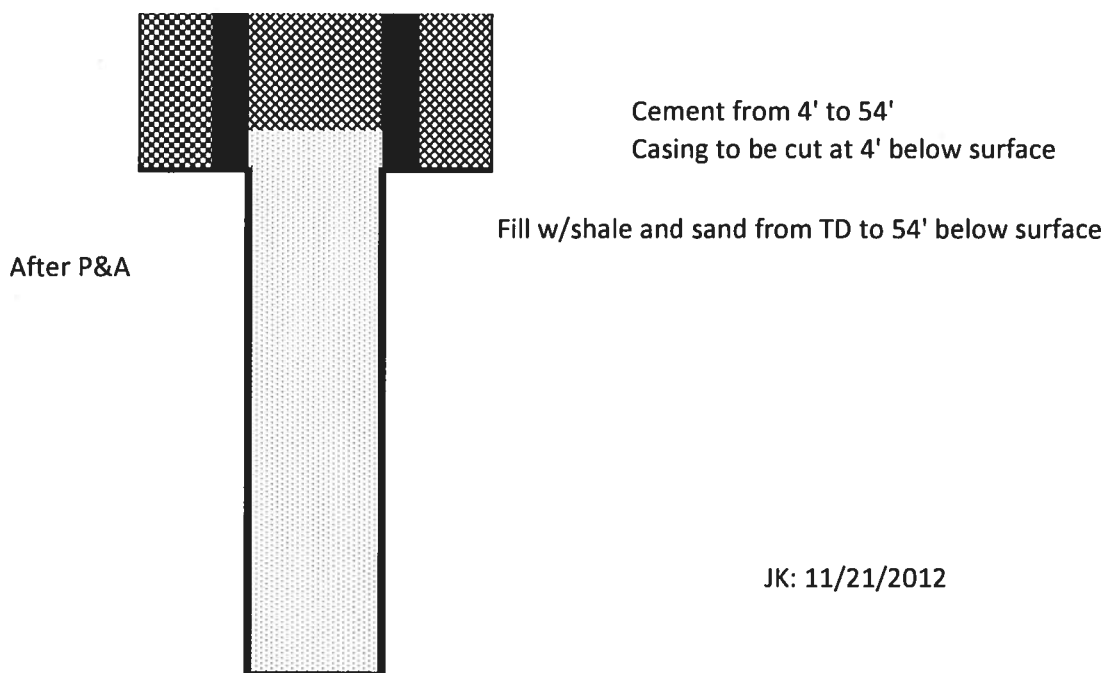


Well Bore Diagrams, Hefley-King #1 (103-40155) SWSW Section 2, T1N, R102W

Surface casing = 8.625", 32#. Presumed depth = 150', in presumed 10.75" open-hole.

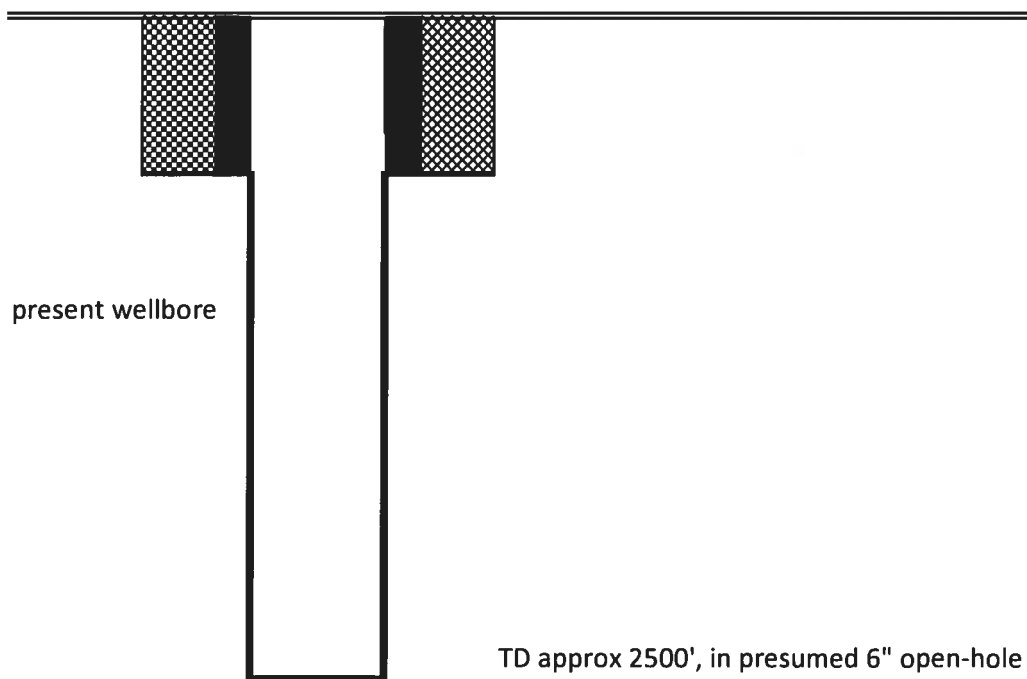

JK: 11/21/2012