

Downhole Schematic for PRATT 2-0-29



Project :DJ Basin

Area : Wattenberg

As Of : 06/09/2012

API # :05123323760000

County :


GL : 5116.0 ft

Surface Location :

BHL :

KB to GL : 13.0 ft

KB : 5129.0 ft

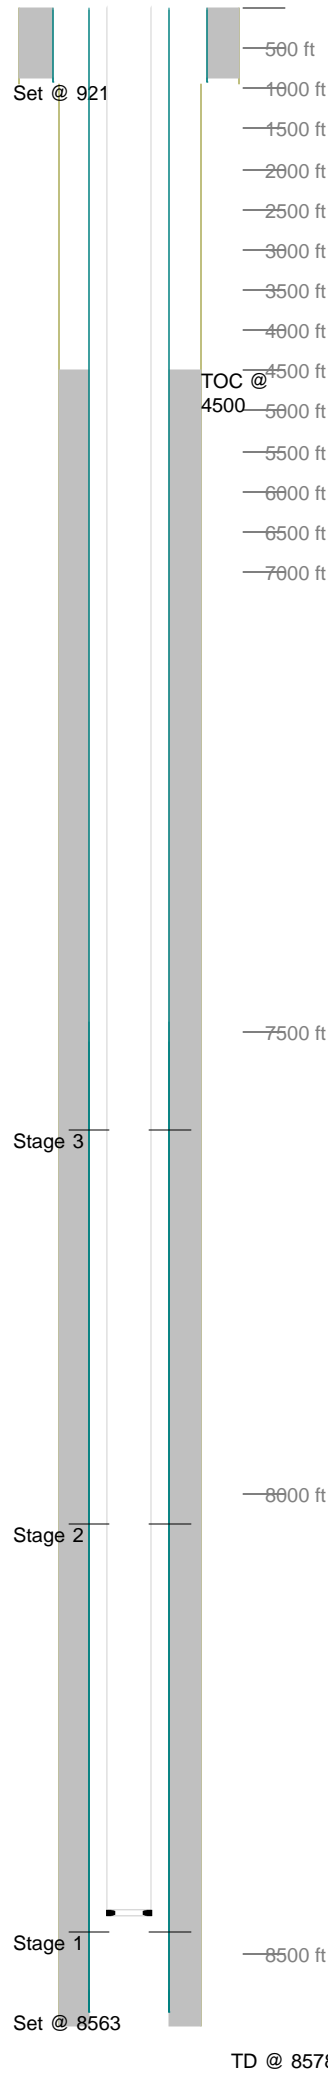

Casing Details								
Section	Hole	Casing	Mass	Set At	Length	Thread	Grade	Description
Surface	12.250		0	921	1		K55	Guide Shoe
		8.625	24	920	41	ST&C	J-55	SJ/BAFFLE
		8.625	24	879	866	ST&C	J-55	CASING
		8.6.5	24	13	13			Landing Joint
Production	7.875		0	8,563	1		K-55	Float Shoe
		4.5	11.6	8,562	22		N-80	Shoe Jt
			0	8,540	1		K-55	Float Collar
		4.5	11.6	8,538	1,029		SB-80	Casing
		4.5	11.6	7,510	21		N-80	Marker Jt
		4.5	11.6	7,489	7,476		SB-80	Casing
		4.5	0	13	13		SB-80	Landing Jt
Cement Details								
Section	Sequence	Top	Density	Blend / Additives				
Surface	Lead	0	14.5	TYPE III Cmt Class C / + 0.08 lbs/sk Static Free + 1.5% Calcium Chloride + 0.15 lbs/sk Cello Flake + 60.5% Fresh Water.				
Production	Lead	4,500	12.5	Premuim Lite Cmt / +0.1% R-3 + 0.2% CD-32 +0.7% FL-63 + 0.2% ASA-301 + 6% Bentonite + 3 lbs/sx CSE-2				
	Tail	7,100	13.5	(50:50 Poz,Fly Ash / Class G Cmt + 0.1% R-3 + 0.6% FL-63 + 3% Bentonite + 0.1% SM + 20% Silica Flour				
Tubing and Downhole Equipment								
O.D.	Length	Depth	Description					
0.000	11.50	11.50	KB					
2.375	8,439.58	8,451.08	268 JTS 4.7# J55 EUE 8RD					
2.375	2.10	8,453.18	Sn & Partial Pump Out Sub					
Perforations								
Stage 1	1				05/17/2012	8,032	8,046	48
	Date	From	To	Shots	Stage 3			
	05/16/2012	8,476	8,496	40	Date	From	To	Shots
Stage 2	2				05/19/2012	7,606	7,618	48
	Date	From	To	Shots				
Frac Summary								
Stage 1 : 8,476 - 8,496, 3609 bbls of Hybrid, 250240 lbs of 20/40 Sand Report Date: 05/17/2012								
Stage 2 : 8,032 - 8,046, 48 - 0.420" shots, 2798 bbls of Slickwater, 250000 lbs of 30-50 Sand Report Date: 05/19/2012								
Stage 3 : 7,606 - 7,618, 48 - 0.420" shots, 3277 bbls of Slickwater, 250000 lbs of 30/50 Sand Report Date: 05/20/2012								