

Well

Operator

Location

County

State

Field

Footages

IONE 4-8-4

EnCana Oil & Gas (USA) Inc.

SESW Section 4-T2N-R66W

WELD

Colorado

Wattenberg

600' FSL; 2205' FWL

Spud Date:

06-09-12


TD Date:

06-14-12

Log Tops

Sussex	4438'
Niobrara	7215'
Codell	7461'
J Sand	7905'

Production Tubing
2-3/8" tubing, set @ 7896'

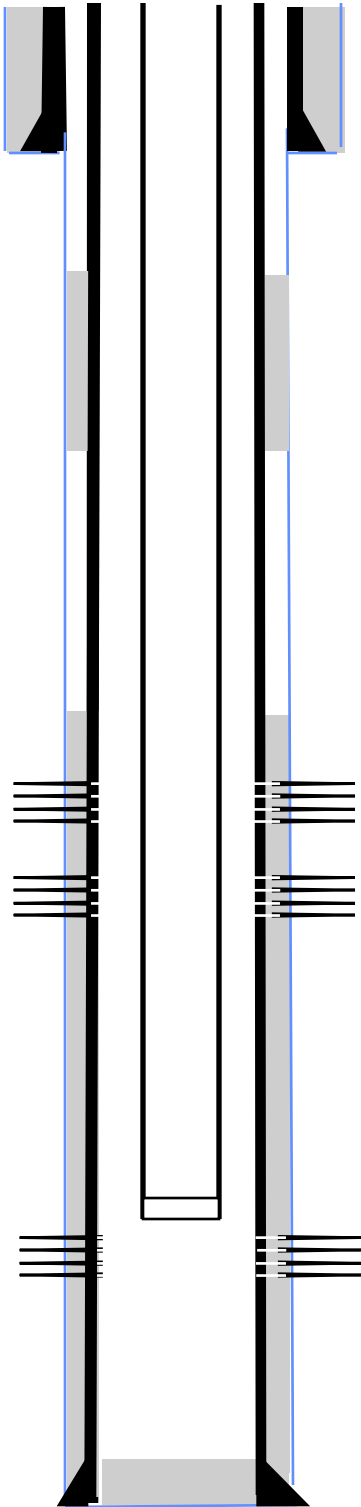

Surface Casing and Cement
8 5/8" , 24#, landed @ 836',cemented with 305 sxs

Main Hole
7-7/8" to TD

Production Casing and Cement
4-1/2", 11.6#, landed @ 8044',cemented with 640 sxs

CBP
Set @ 7220'. 08-12-12
Drilled out on 08-17-12

Perf'd the Niobrara from 7263' – 7275' @ 4 spf
Frac'd the Niobrara 7,263' – 7,275' (48 holes), w/ 99,264 gals
18 # Vistar Hybrid cross linked gel containing 250,000 # 30/50
sand. 06-26-12

CFP
Set @ 7325'. 06-26-12
Drilled out on 08-17-12

Perf'd the Codell from 7462' – 7476' @ 4 spf
Frac'd the Codell 7,462' – 7,476' (42 holes) w/ 87,066 gal 22#
Vistar Hybrid cross linked gel containing 250,460 # 20/40 sand.
06-26-12.

CFP
Set @ 7530'. 06-26-12
Drilled out on 08-17-12

Perf'd the J Sand from 7906' - 7952' @ 4 spf
Frac'd the J-Sand 7,906' – 7,911', 7,932'- 7,952' (50 holes)w/
61,782 gal 18 # Vistar Hybrid cross linked gel containing 250,000
20/40 Sand. 06-25-12

8055'

—

Driller's TD