


PRODUCTION FACILITY LOCATION DRAWING

SAUER F33-76-1HN TANK

SECTION: 33
TOWNSHIP: 5N
RANGE: 65W

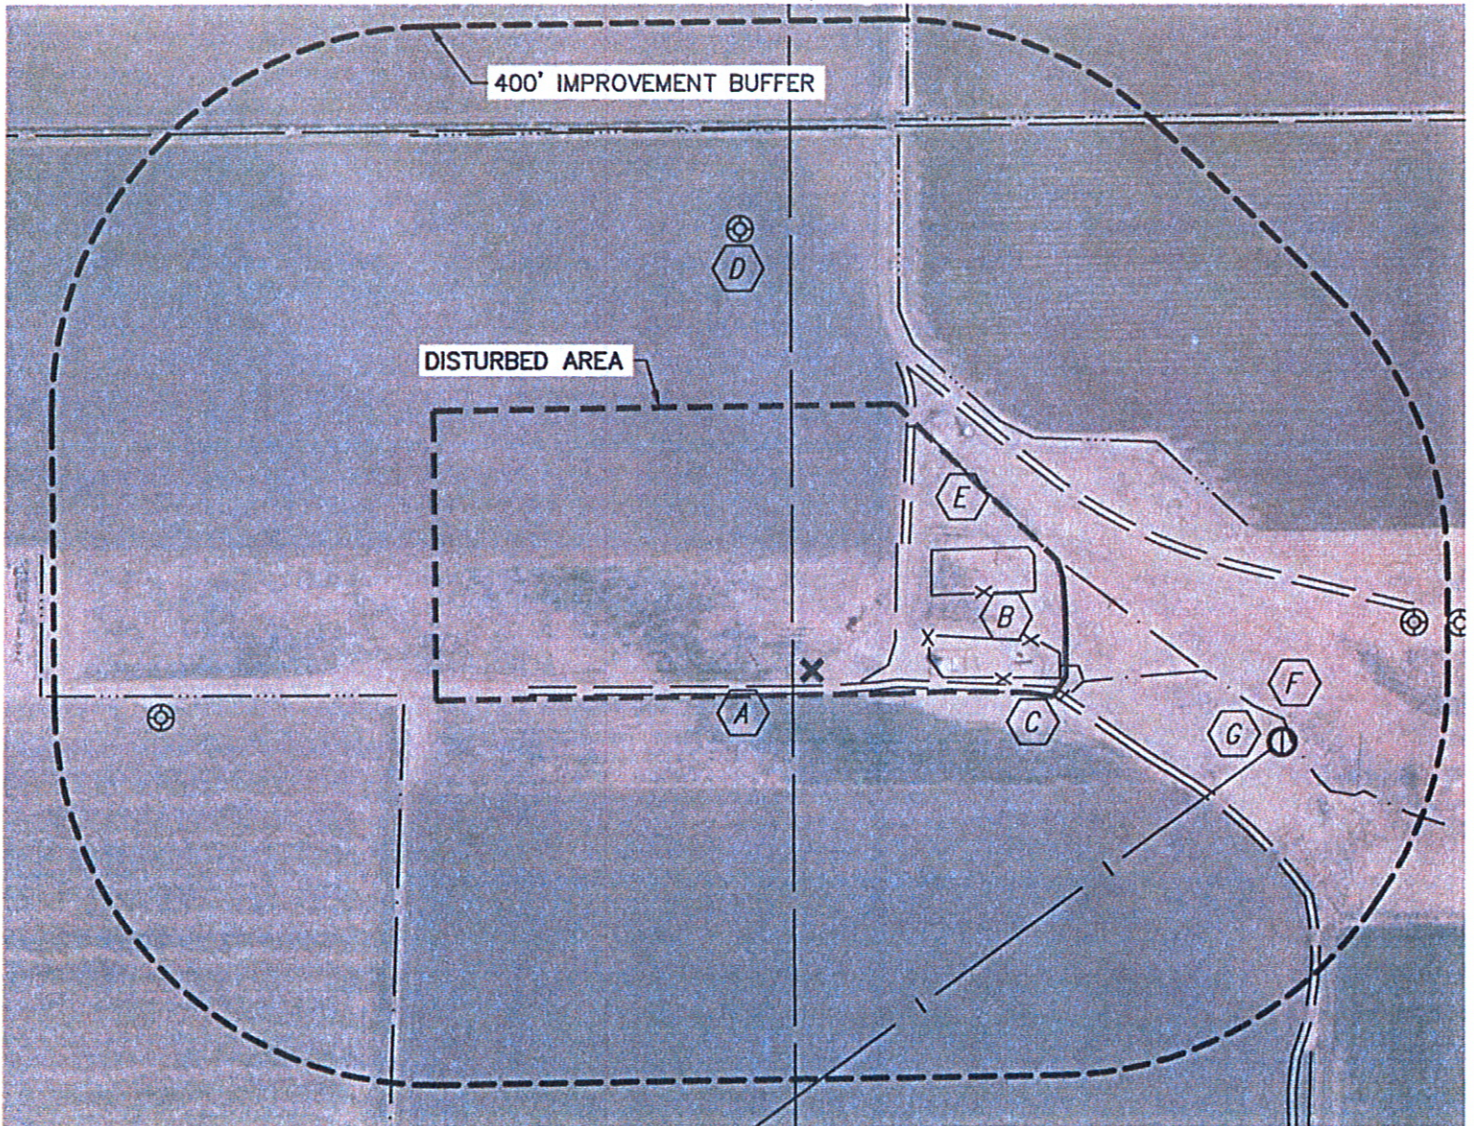

REFERENCE POINT LOCATION:

LATITUDE: 40.35057°N
LONGITUDE: 104.67304°W

ELEV: 4664'

PDOP: 1.0

DATE: 11/13/12

OPERATOR: ADAM KELLY

1/41/4: SE1/4SW1/4

FSL: 762'

FWL: 1343'

DISTANCE TO WELL: 599'

ASSOCIATED NEW WELLS:

SAUER F33-76-1HN,

77-1HN, 77-1HC,

77HN, 78-1HC, 78-1HN

ASSOCIATED EXISTING WELLS:

SAUER 1


SAUER F33-33, 33-25

SAUER G04-29D, 28D

SAUER 33-2

IMPROVEMENTS:

- A** FIELD ROAD 16' S, 307' NE
- B** EX. PRODUCTION EQUIPMENT (NOBLE) 123' E 147' NE
- C** CULVERT 260' SE
- D** EX. OIL & GAS WELL 465' NW, 632' NE, 685' SW
- E** DITCH 260' NE, 274' E, 325' NE, 430' W, 562' N, 580' & 595' NE
- F** POND 507' E
- G** IRRIGATION PUMP 498' SE

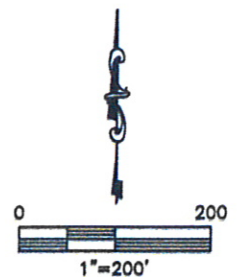

LEGEND

X - REFERENCE POINT
ALL DISTANCES ARE APPROXIMATE.

NEAREST: BUILDING 838' S (DWELLING),
PUBLIC ROAD 749' S (CR 50), ABOVE GROUND UTILITY 781' S,
RAILROAD 2400' NW, PROPERTY LINE 564' N

DATE: rev11/13/2012
PROJECT#: 2011334