

WPX Energy Rocky Mtn LLC

FINAL

RWF # 312-35


API #05-045-20450-00

2001' FNL x 541' FWL - SHL

1847' FNL x 628' FWL - BHL

(SWNW) Sec. 35-T6S-R94W

Garfield County, Colorado

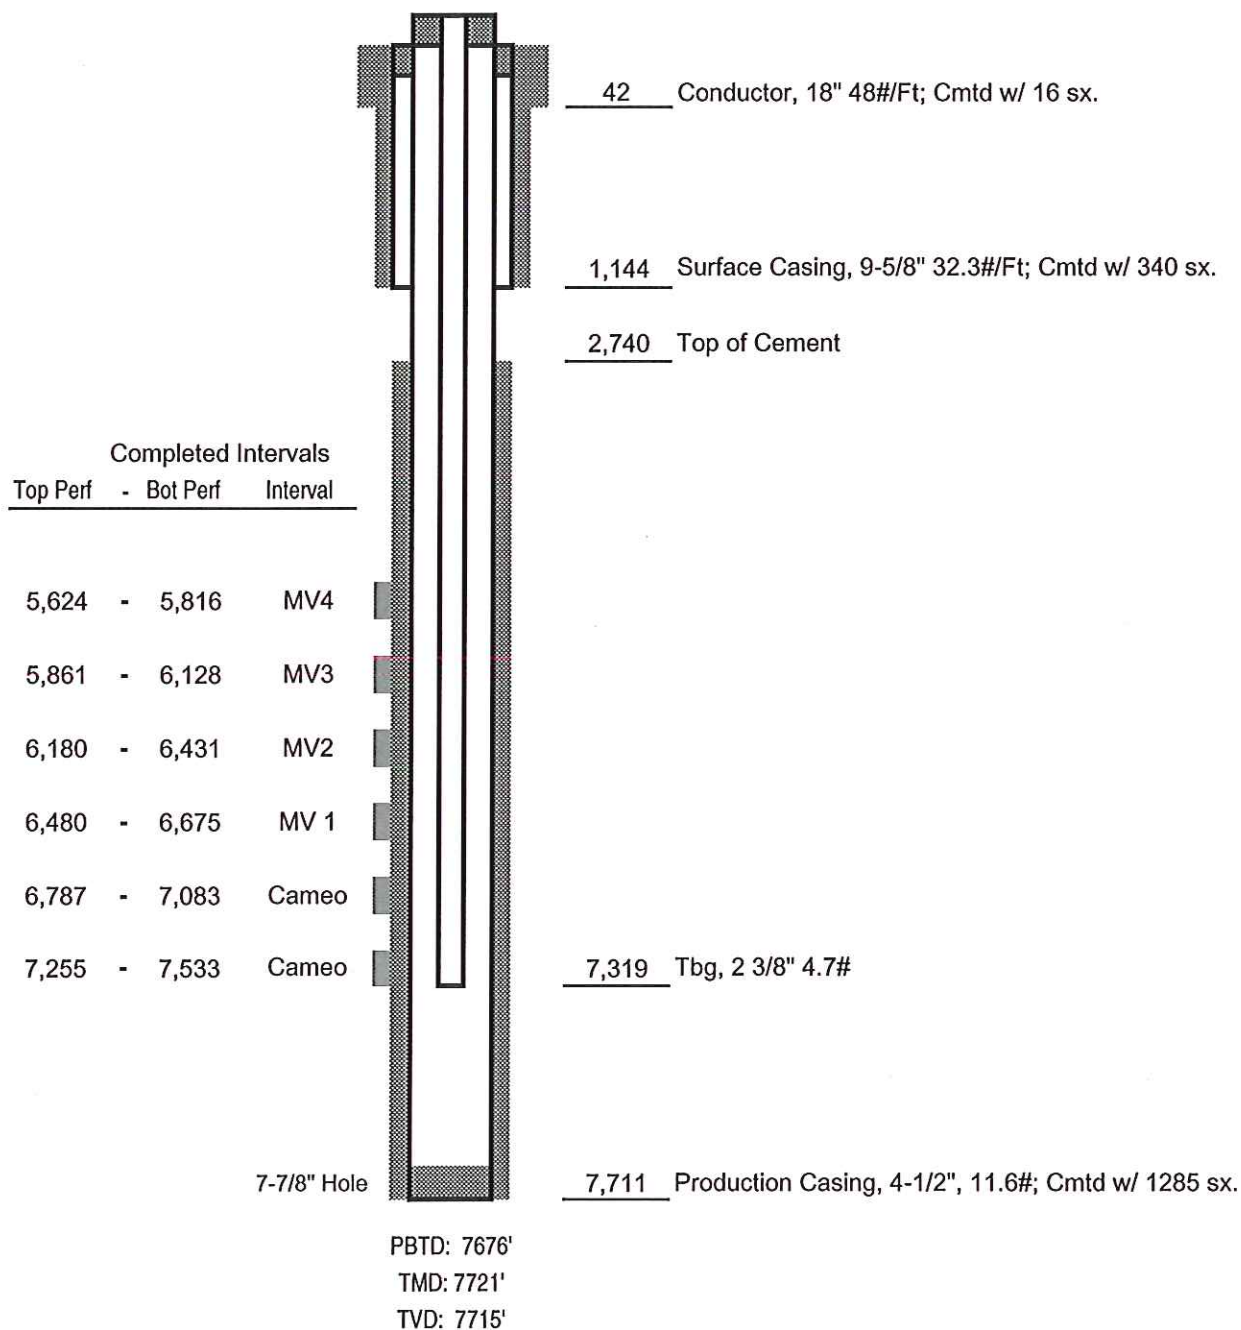

Not to Scale