

Department of the Interior
Geological Survey
Conservation Branch




Case 4

Township Well Record Plat

Greasewood

T. _____ R. _____ Mer. State _____

□ Area suggested by Shannon

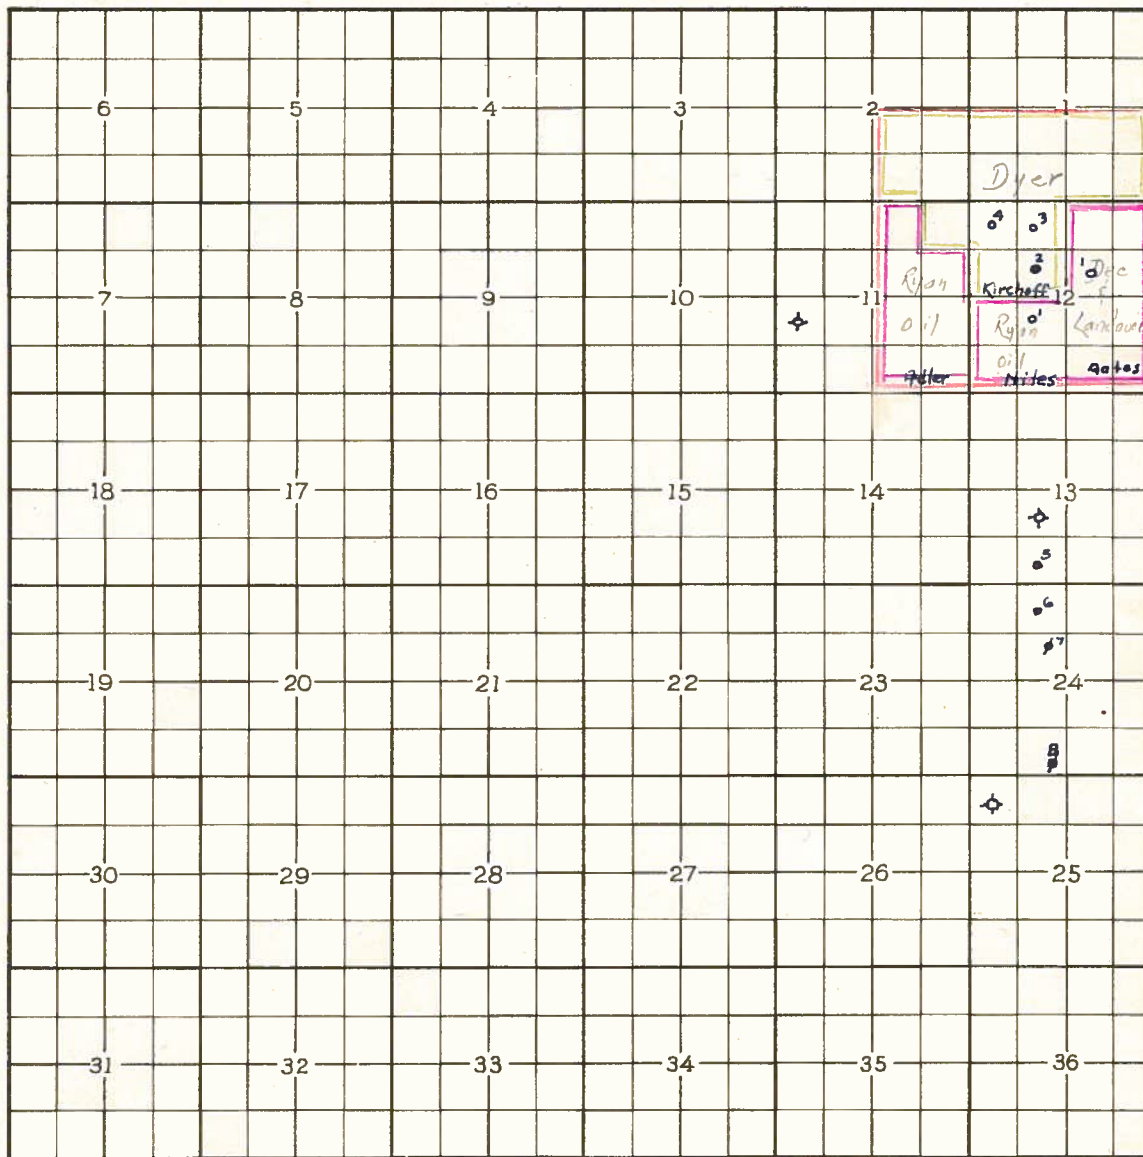

Scale: 1 inch = 1 mile

ENGRAVED AND PRINTED BY THE GEOLOGICAL SURVEY

0 1000 5000 feet
0 1820 2640 5280 feet