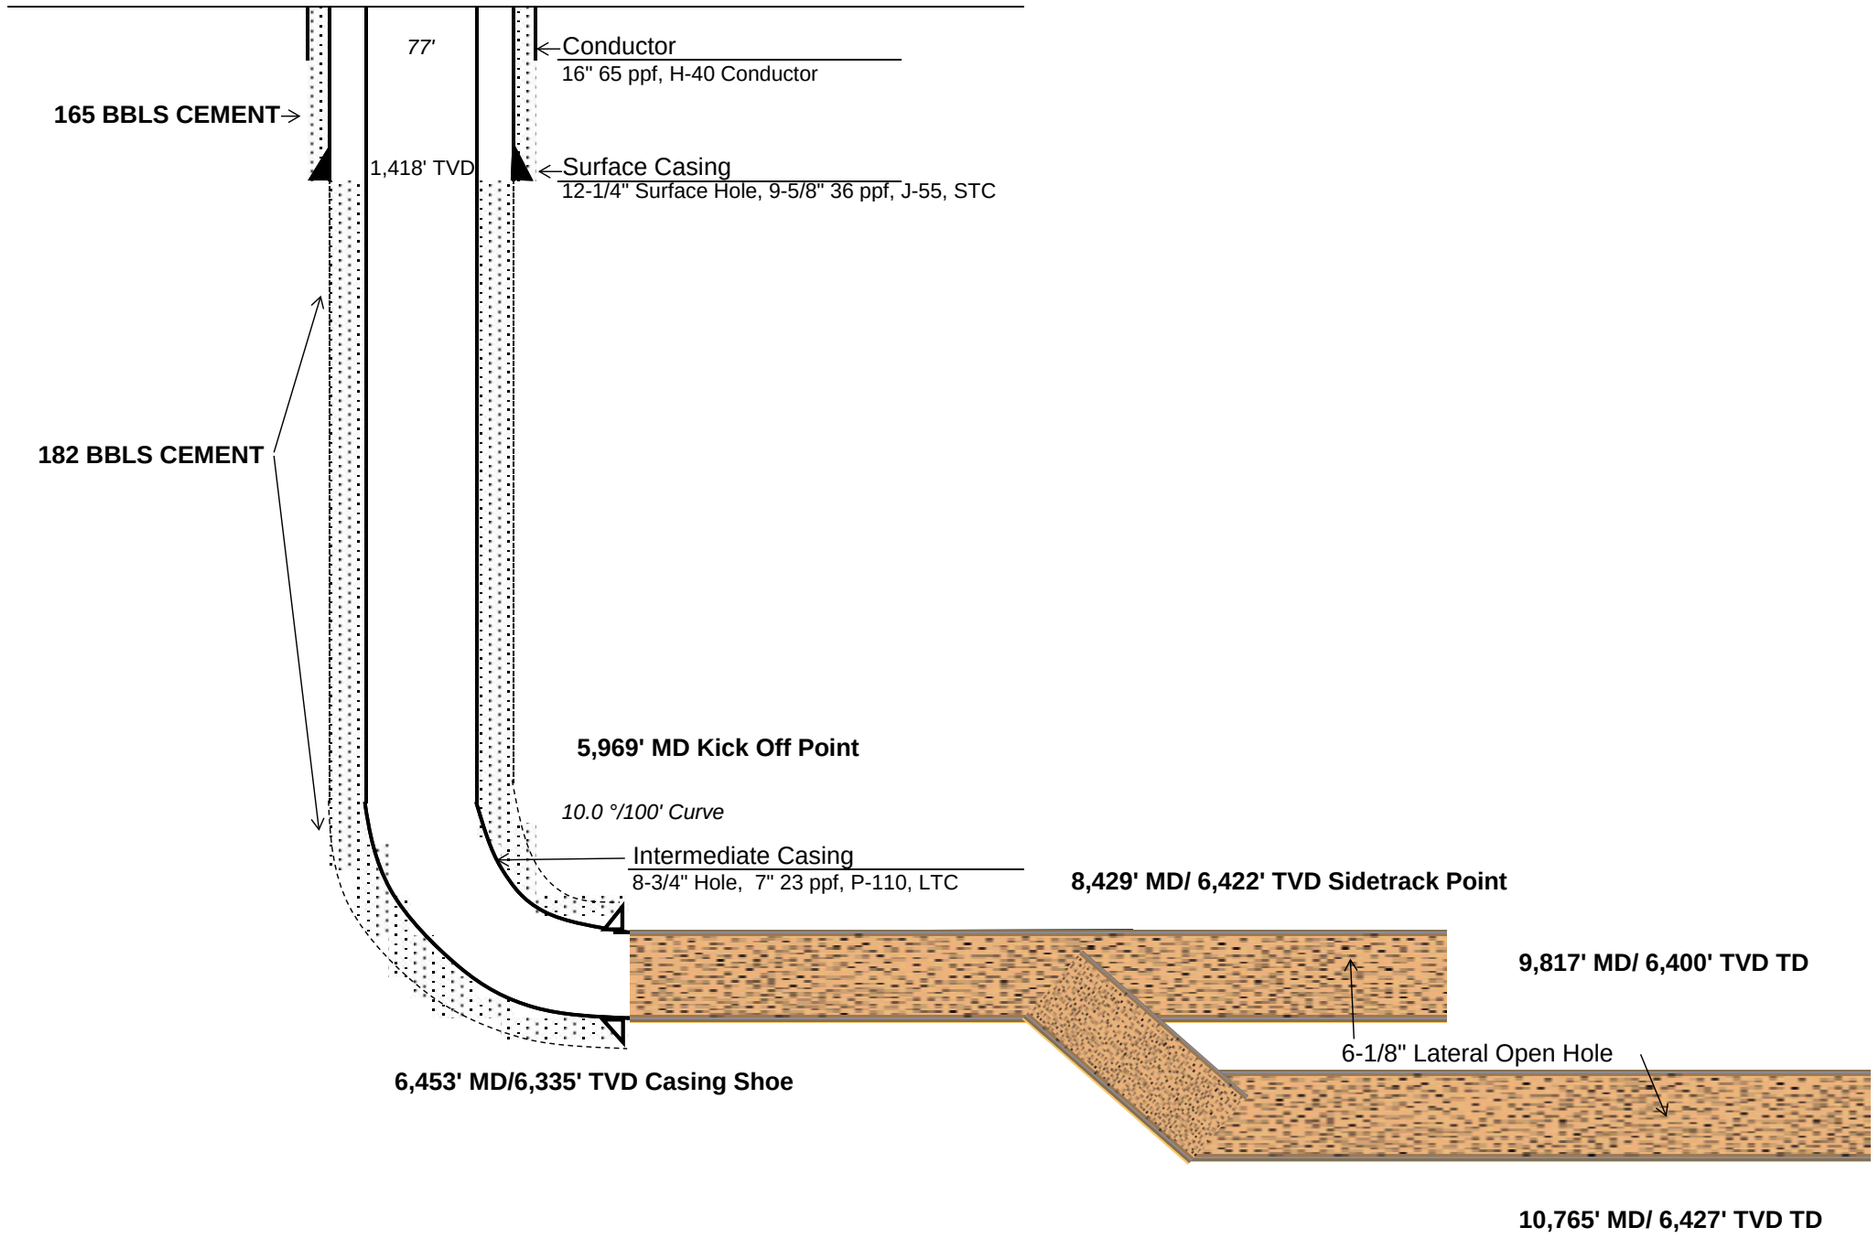NELSON 1-20-9-60 SIDE TRACK WELLBORE