

WPX Energy Rocky Mtn LLC

RWF 342-34

API #05-045-20457-00

2021' FNL x 528' FWL - SHL


(SWNW) Sec. 35-T6S-R94W

1635' FNL x 929' FEL - BHL

(SENE) Sec. 34-T6S-T94W

Garfield County, Colorado

FINAL

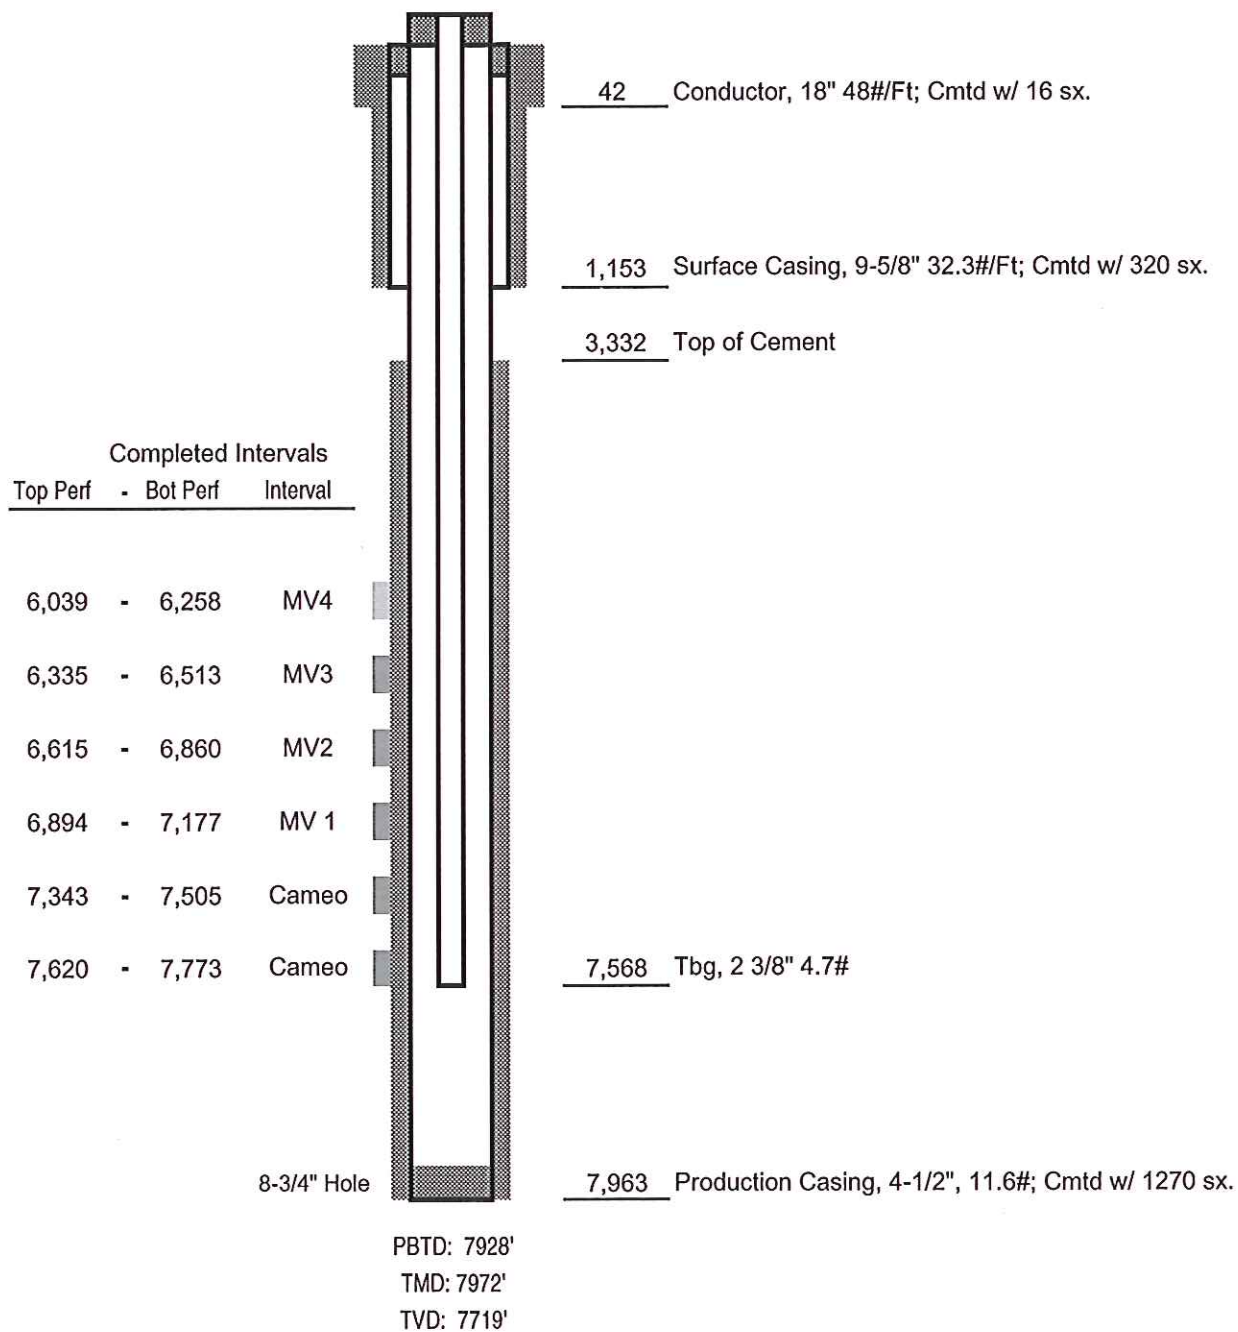

Not to Scale