

WPX Energy Rocky Mountain Company, LLC

Jolley KP 424-9

Kokopelli Field

SHL 616' FNL 707' FWL (NW/4 NW/4) BHL 512' FSL 2004' FWL (SE/4 SW/4, Sec. 9, T6S, R91W)

Section 16-T6S-R91W 6th PM

Garfield County, Colorado

Formation Tops

(Measured Depths)

Mesaverde @ 3678'


Cameo @ 7146'

Rollins @ 7411'

PBTD @

TMD @ 7690'

TVD @ 7235'

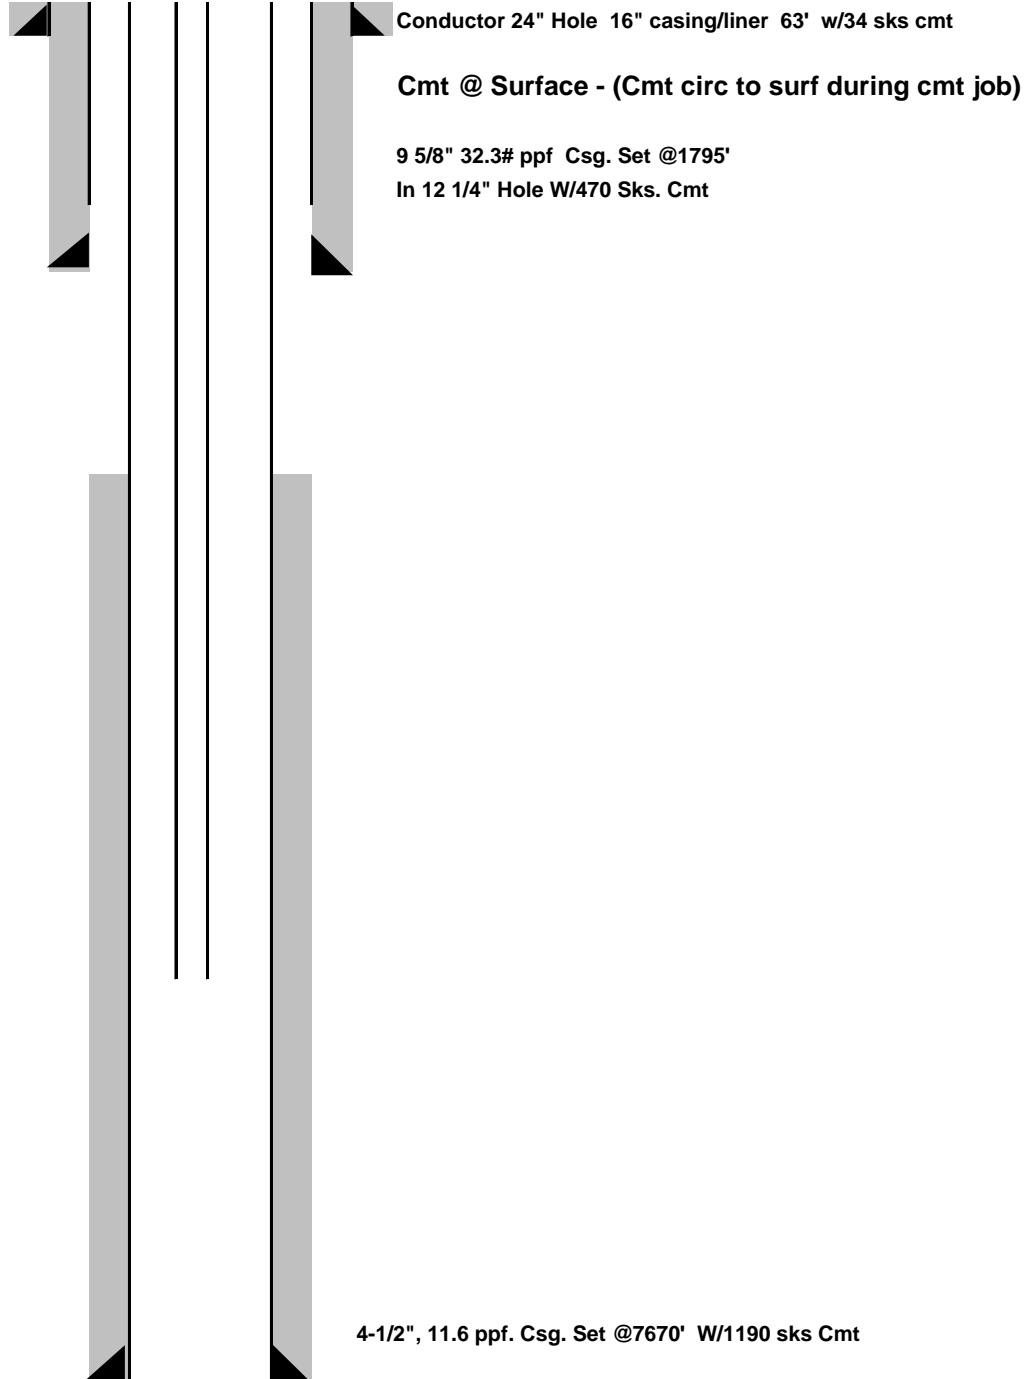

4-1/2", 11.6 ppf. Csg. Set @7670' W/1190 sks Cmt