





THIS MAP DOES NOT REPRESENT A BOUNDARY SURVEY

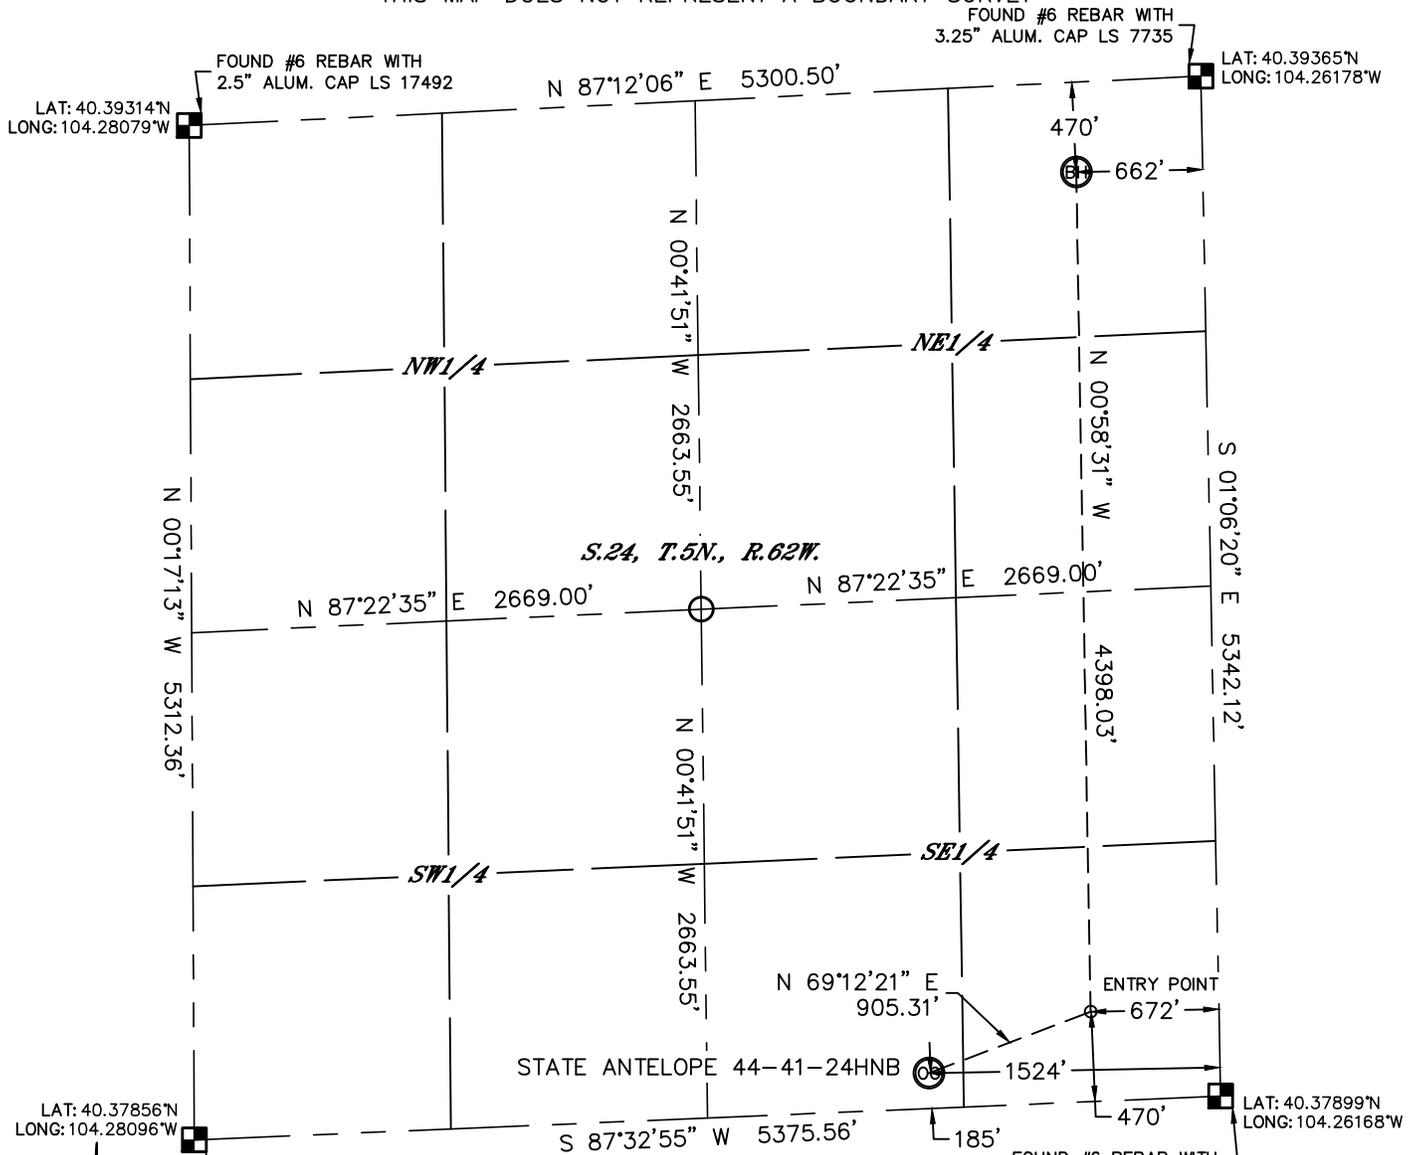



In accordance with a request from Michael Meagher with BONANZA CREEK ENERGY, INC. Lat40°, Inc. has determined the surface location of the STATE ANTELOPE 44-41-24HNB to be 185' from the SOUTH line and 1524' from the EAST line and the bottom hole to be 470' from the NORTH line and 662' from the EAST line as measured at right angles from the section lines of Section 24, Township 5 North, Range 62 West of the Sixth Principal Meridian, County of Weld, State of Colorado.

I hereby state that this Well Location Certificate was prepared by me, or under my direct supervision, that the fieldwork was completed on 10/8/2012, for and on behalf of BONANZA CREEK ENERGY, INC. That this is not a Land Survey Plat or an Improvement Survey Plat, and that it is not to be relied upon for establishment of fence, building, or other future improvement lines.

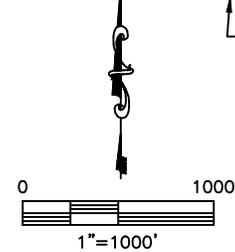

- NOTE:**
- 1) Bearings shown are Grid Bearings of the Colorado State Plane Coordinate System, North Zone, North American Datum 1983/2007. The lineal dimensions as contained herein are based upon the "U.S. Survey Foot."
 - 2) Ground elevations are based on an observed GPS elevation (NAVD 1988 DATUM).
 - 3) IMPROVEMENTS: See LOCATION DRAWING for all visible improvements within 400' of disturbed area.
 - 4) SURFACE USE: RANGELAND
 - 5) INSTRUMENT OPERATOR: WYATT HALL

SURFACE LOCATION	ENTRY POINT	BOTTOM HOLE
LAT: 40.37937N	LAT: 40.38022N	LAT: 40.39229N
LONG: 104.26715W	LONG: 104.26410W	LONG: 104.26415W
PDOP: 1.3	1/4,1/4: SE1/4SE1/4	1/4,1/4: NE1/4NE1/4
ELEV: 4517'		
1/4,1/4: SW1/4SE1/4		
NEAREST PROPERTY LINE: 185' S		

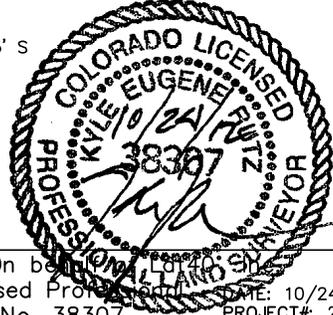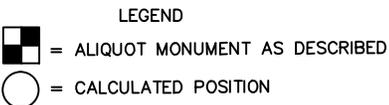

Kyle E. Rutz—On behalf of
 Colorado Licensed Professional Land Surveyor No. 38307
 DATE: 10/24/2012
 PROJECT#: 2012144

NOTE
 According to Colorado law, you must commence any legal action based upon any defect in this W.L.C. within three years after you discover such defect. In no event, may any action based upon any defect in this survey be commenced more than ten years after the date of the certificate shown hereon. (13-80-105 C.R.S.)