


Mountain Petroleum Corporation  
 Current Wellbore Diagram -- 10/5/2012  
 Frerichs 1-30      API #05-125-06198-00  
 SESE Sec. 30-T1S-R44W  
 Yuma County, Colorado

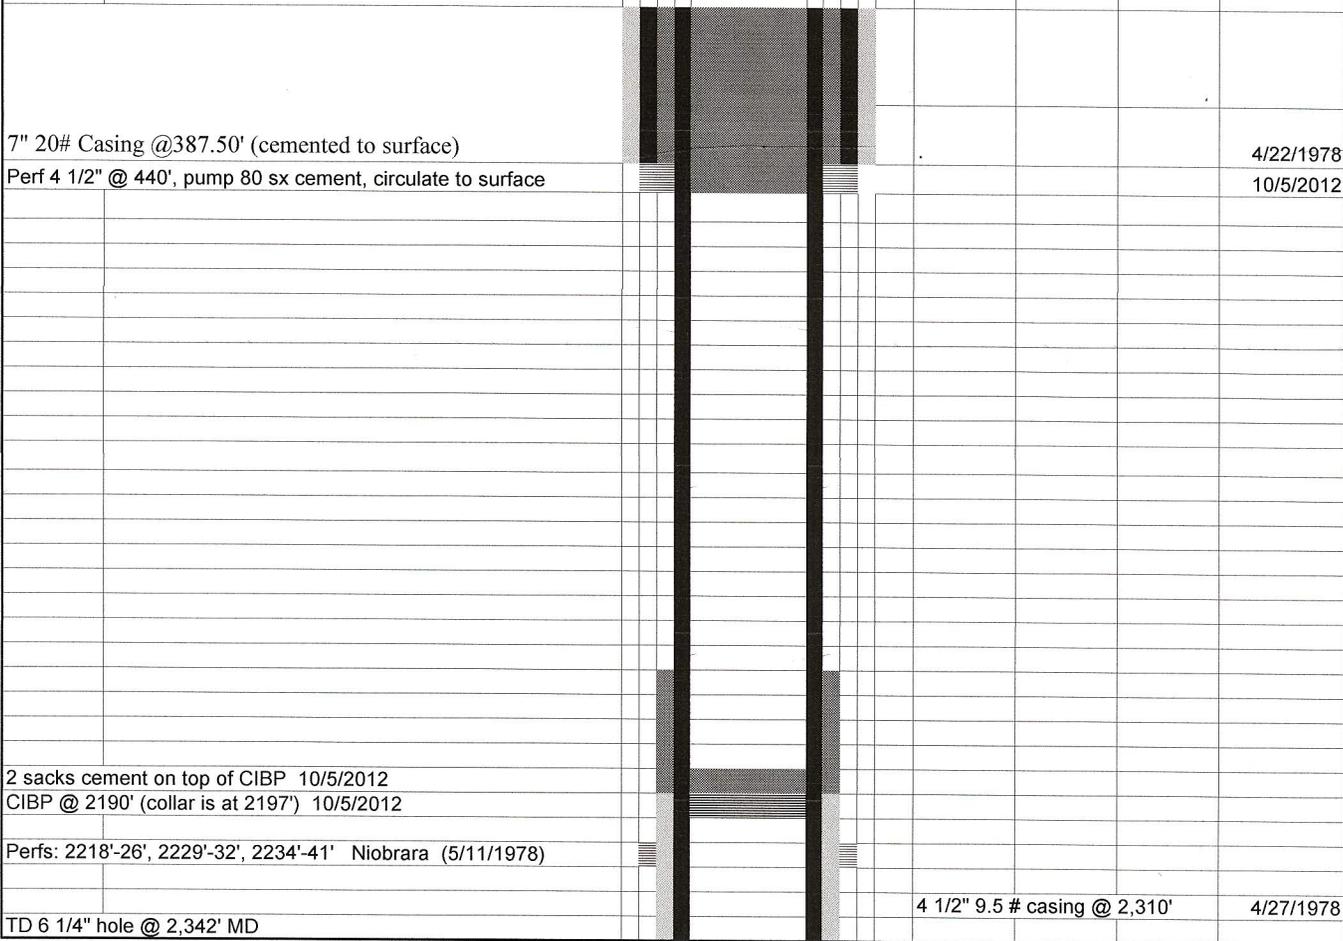

7" 20# Casing @387.50' (cemented to surface) 4/22/1978  
 Perf 4 1/2" @ 440', pump 80 sx cement, circulate to surface 10/5/2012

2 sacks cement on top of CIBP 10/5/2012  
 CIBP @ 2190' (collar is at 2197') 10/5/2012  
 Perfs: 2218'-26', 2229'-32', 2234'-41' Niobrara (5/11/1978)

TD 6 1/4" hole @ 2,342' MD 4 1/2" 9.5 # casing @ 2,310'      4/27/1978