


MOFFAT ENGINEERING SERVICES

Gunbarrel Business Park
6395 Gunpark Drive — Penthouse
Boulder, Colorado 80301
303-530-0608

N

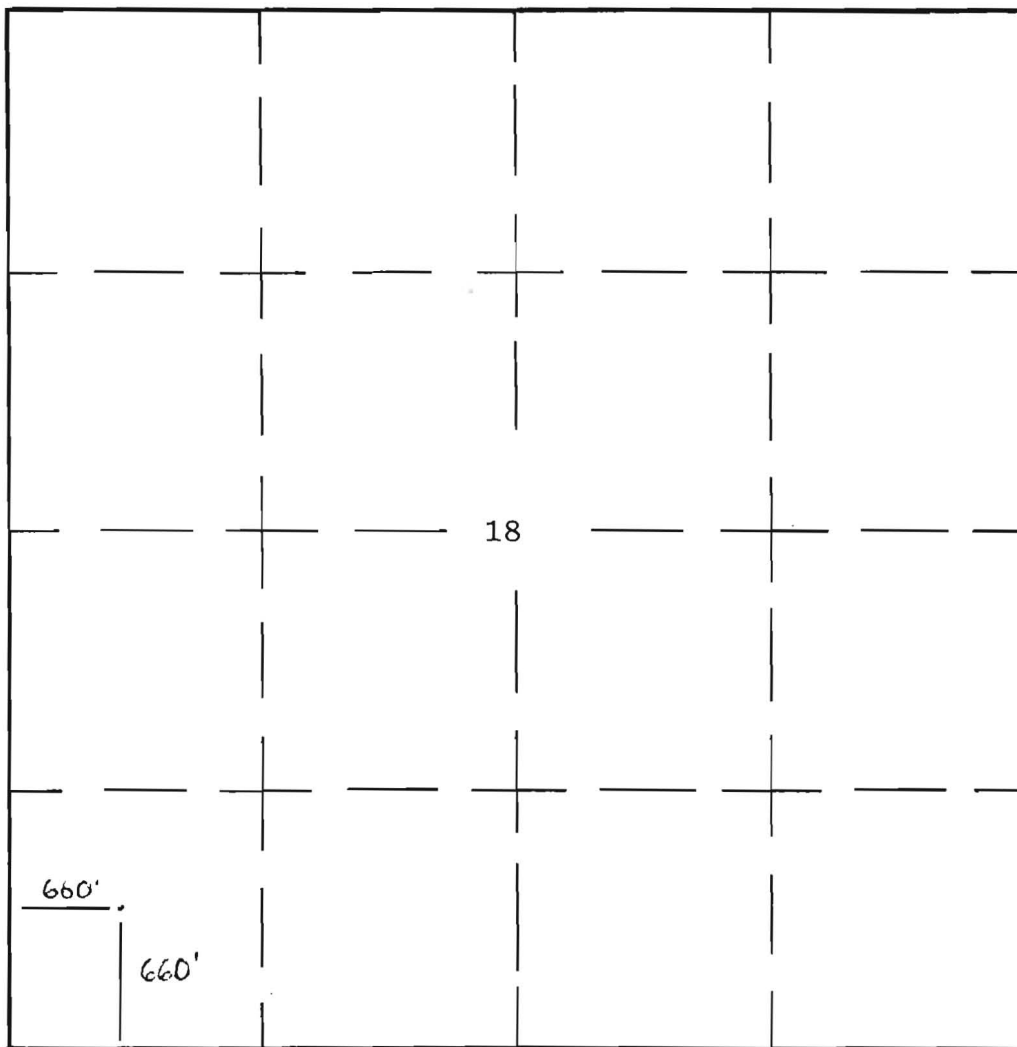

SCALE : 1" = 1000'

In accordance with a request from Sierra Energy,
Moffat Engineering has surveyed and staked the Sierra
Amen No. 1 at the following location and elevation.

Location: 660' FSL, 660' FWL (SW $\frac{1}{4}$ -SW $\frac{1}{4}$) Section 18 T5N R67W
in the 6th P.M., Weld County, Colorado

Elevation: 4884.2

Merlyn L. Ridlen, Surveyor