

## WELLBORE DIAGRAM

Vecta Oil & Gas, LTD

Prepared by: M Goolsby 12/05/12

Maroon 24-20

SE SW Sec 20-T14S-R47W


GL 4242

Cheyenne

Colorado

KB 4253

API: 05-017-07718

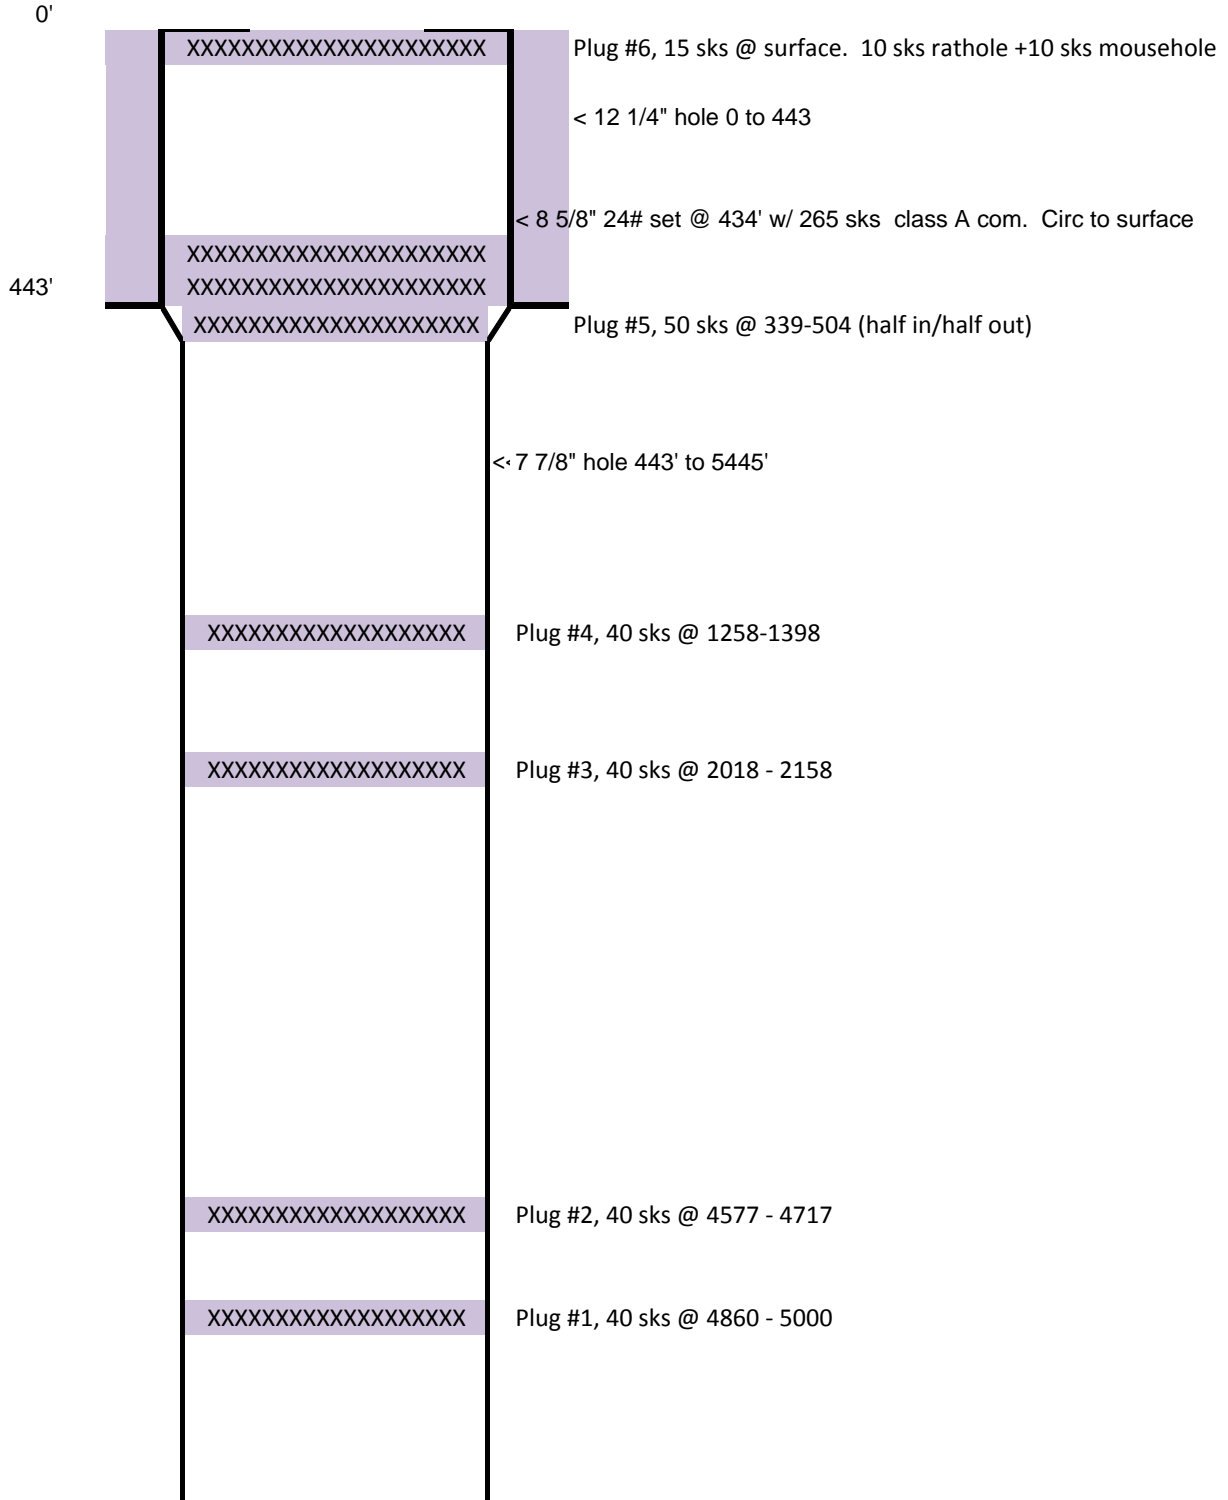

DTD 5445'

Log TD 5442'