


VENRICK 5A - NEWBORE (CURRENT)

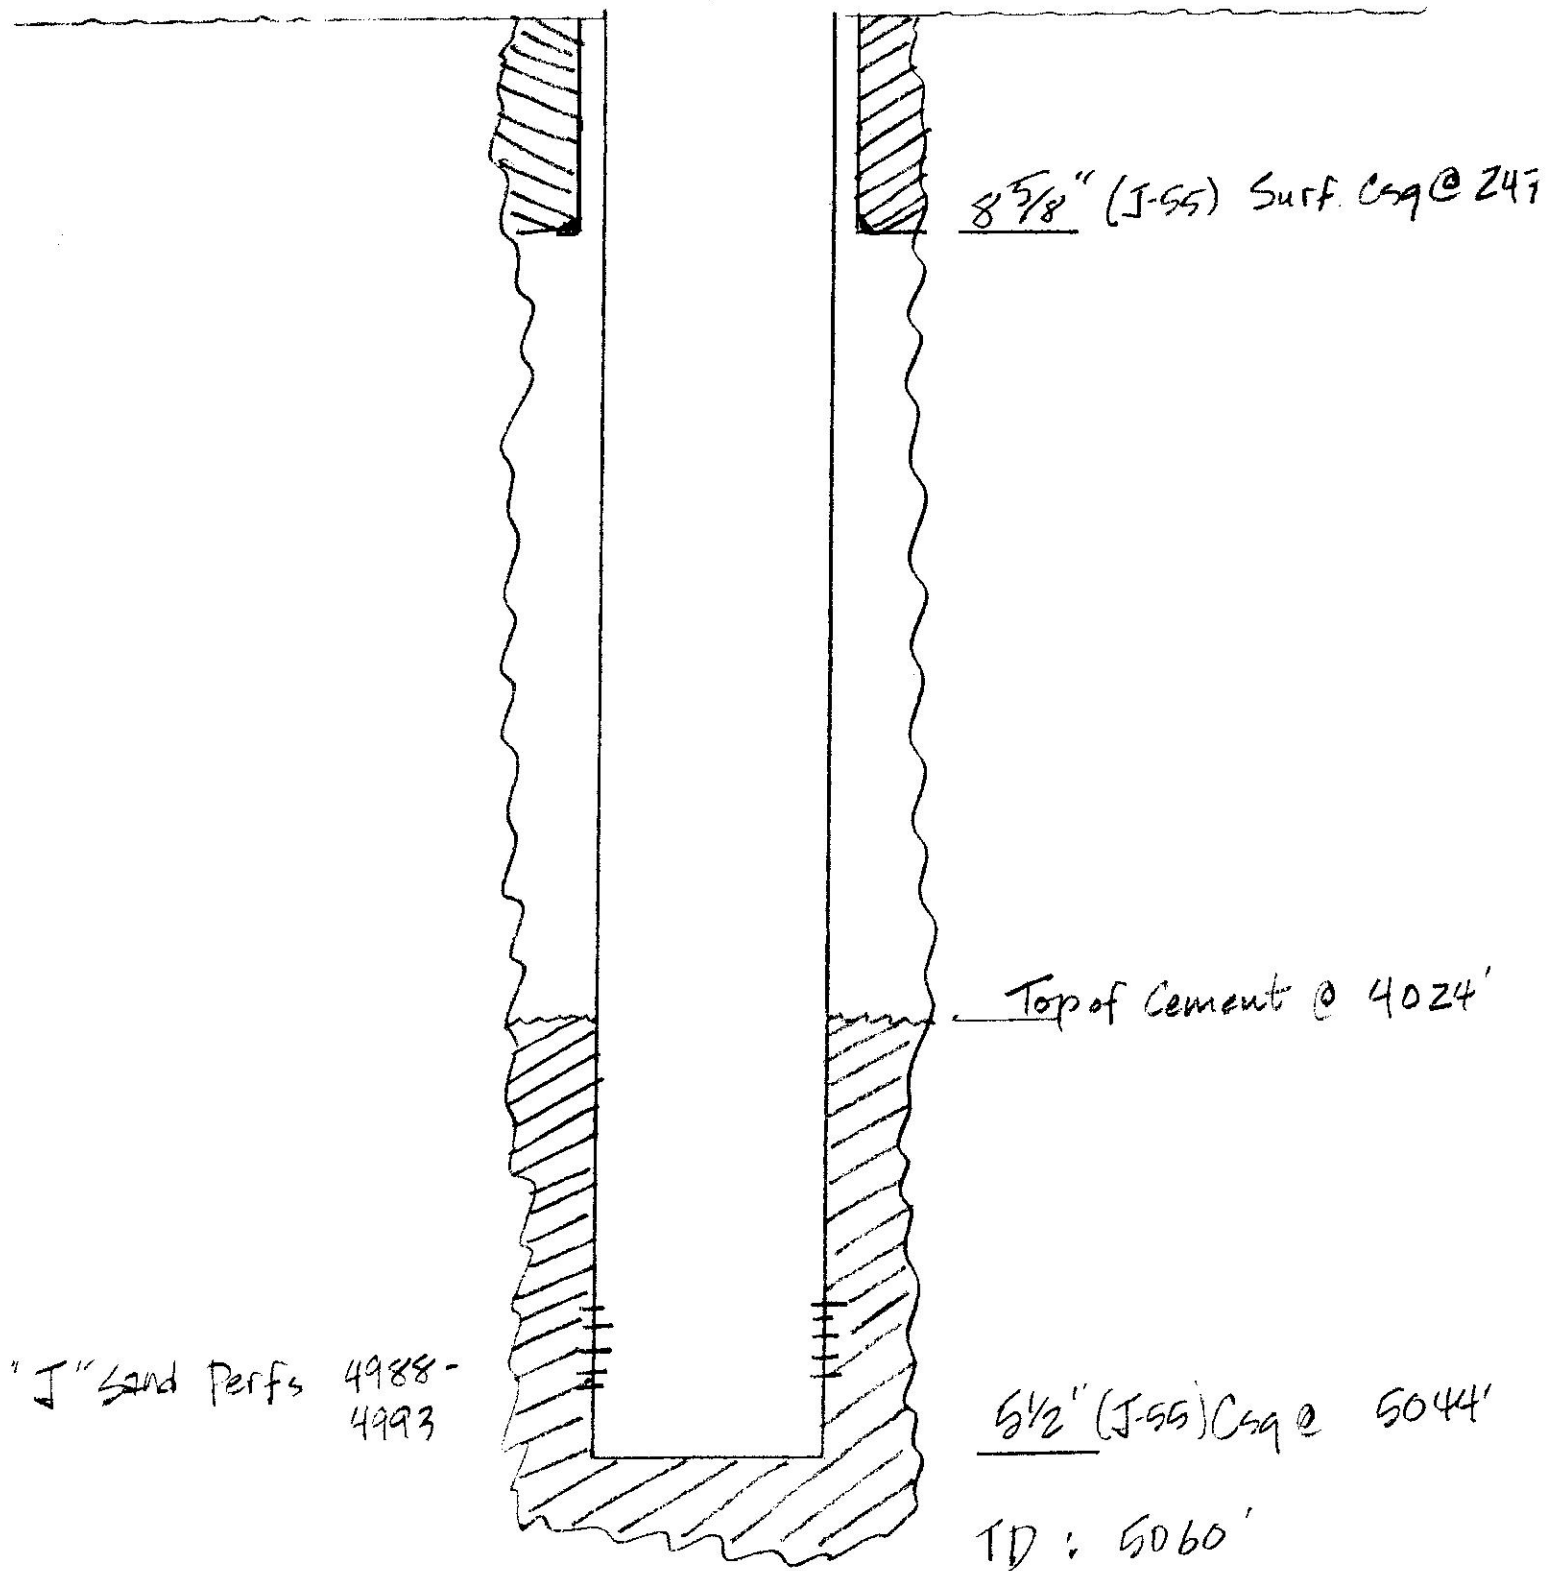

VENRICK 5A - NEWBORE (w/ Plugs)

