



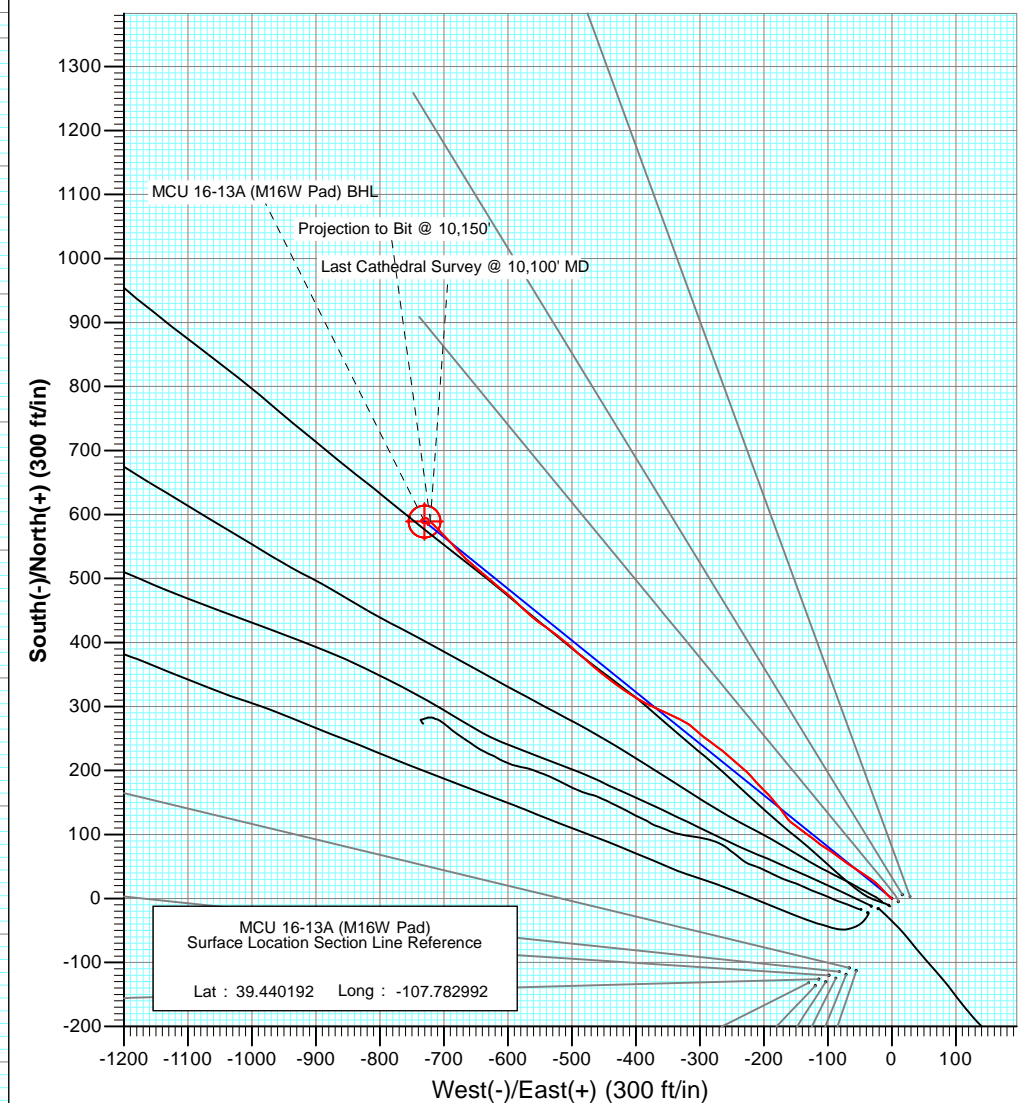


Project: Mamm Creek
 Site: M16W Pad (SWSW S16-T7S-R93W)
 Well: MCU 16-13A (M16W Pad)
 Wellbore: DD
 Plan: FINAL

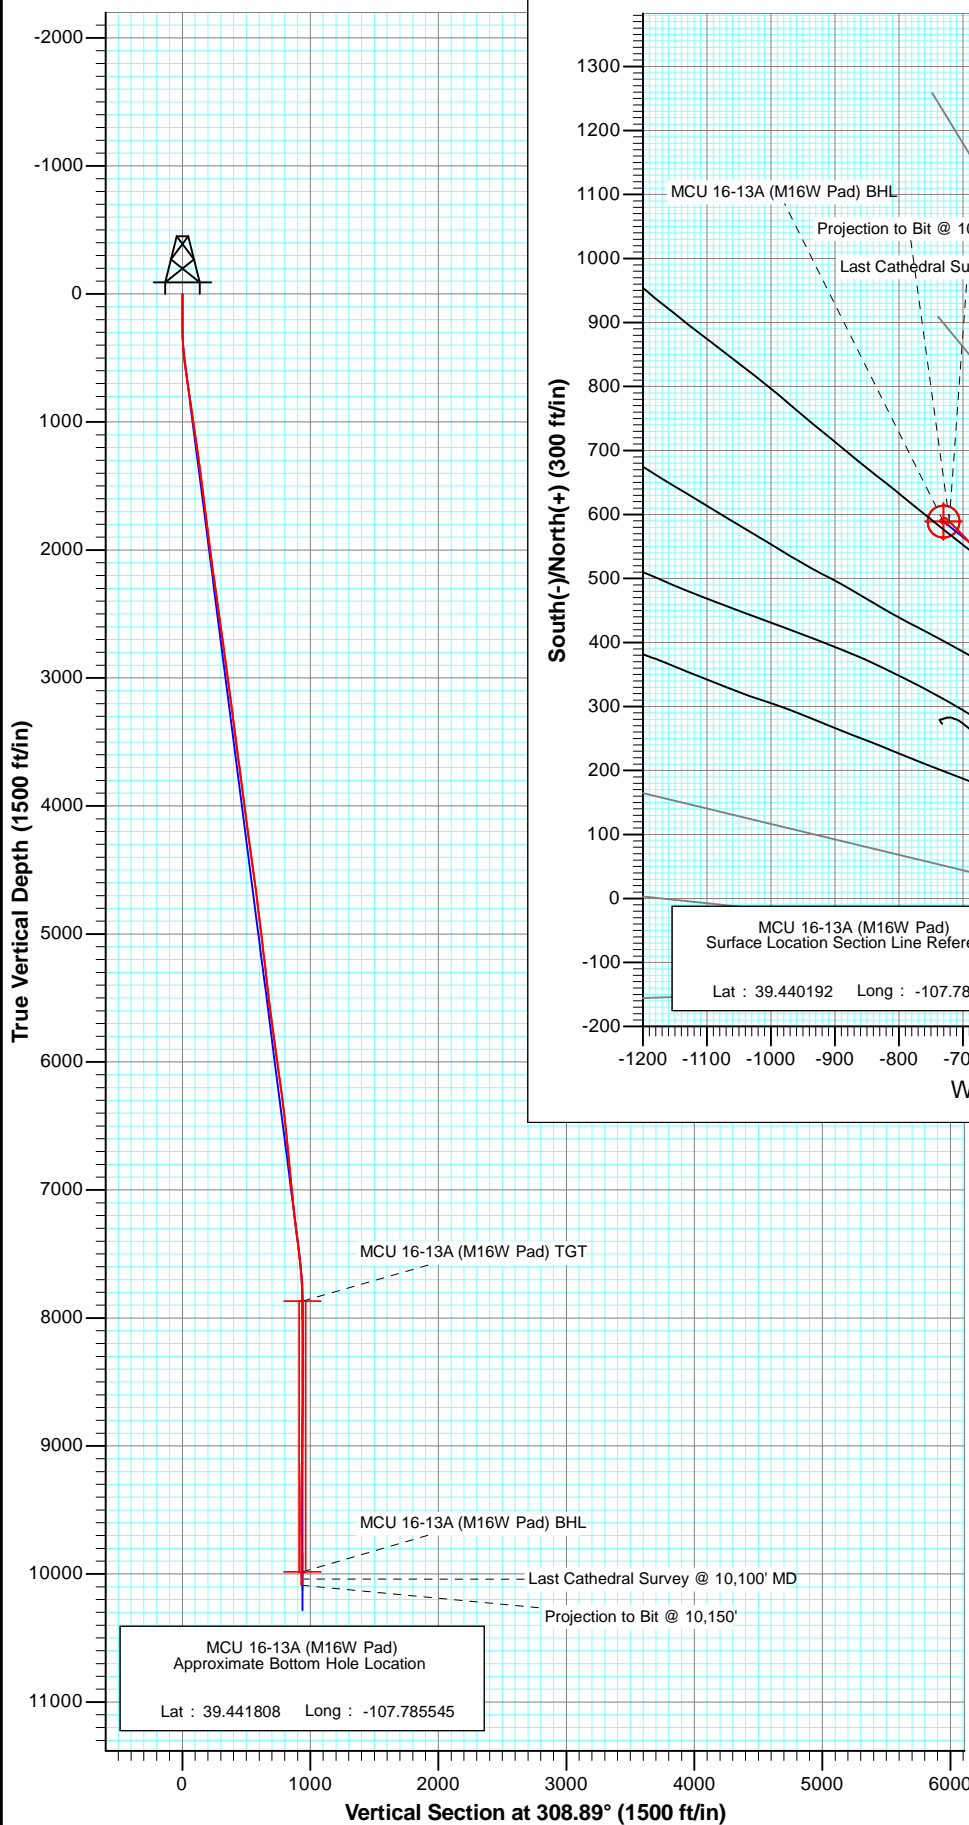


Azimuths to True North
 Magnetic North: 10.09°

Magnetic Field
 Strength: 52105.8nT
 Dip Angle: 65.70°
 Date: 9/14/2012
 Model: IGRF2010

DD					
MCU 16-13A (M16W Pad)					
125449/179155 (SH) 125534/182455 (MH); SC					
KBE @ 7903.0ft (Patterson #308)					
North American Datum 1983					
Well MCU 16-13A (M16W Pad), True North					
Target	Azimuth	Origin	Type	N/S	
MCU 16-13A (M16W Pad) BHL	308.89	Slot		0.0	
Name	TVD	+N/-S	+E/-W	Latitude	Longitude
MCU 16-13A (M16W Pad) TGT	7868.0	589.0	-730.3	39.441809	-107.785578
MCU 16-13A (M16W Pad) BHL	984.0	589.0	-730.3	39.441809	-107.785578

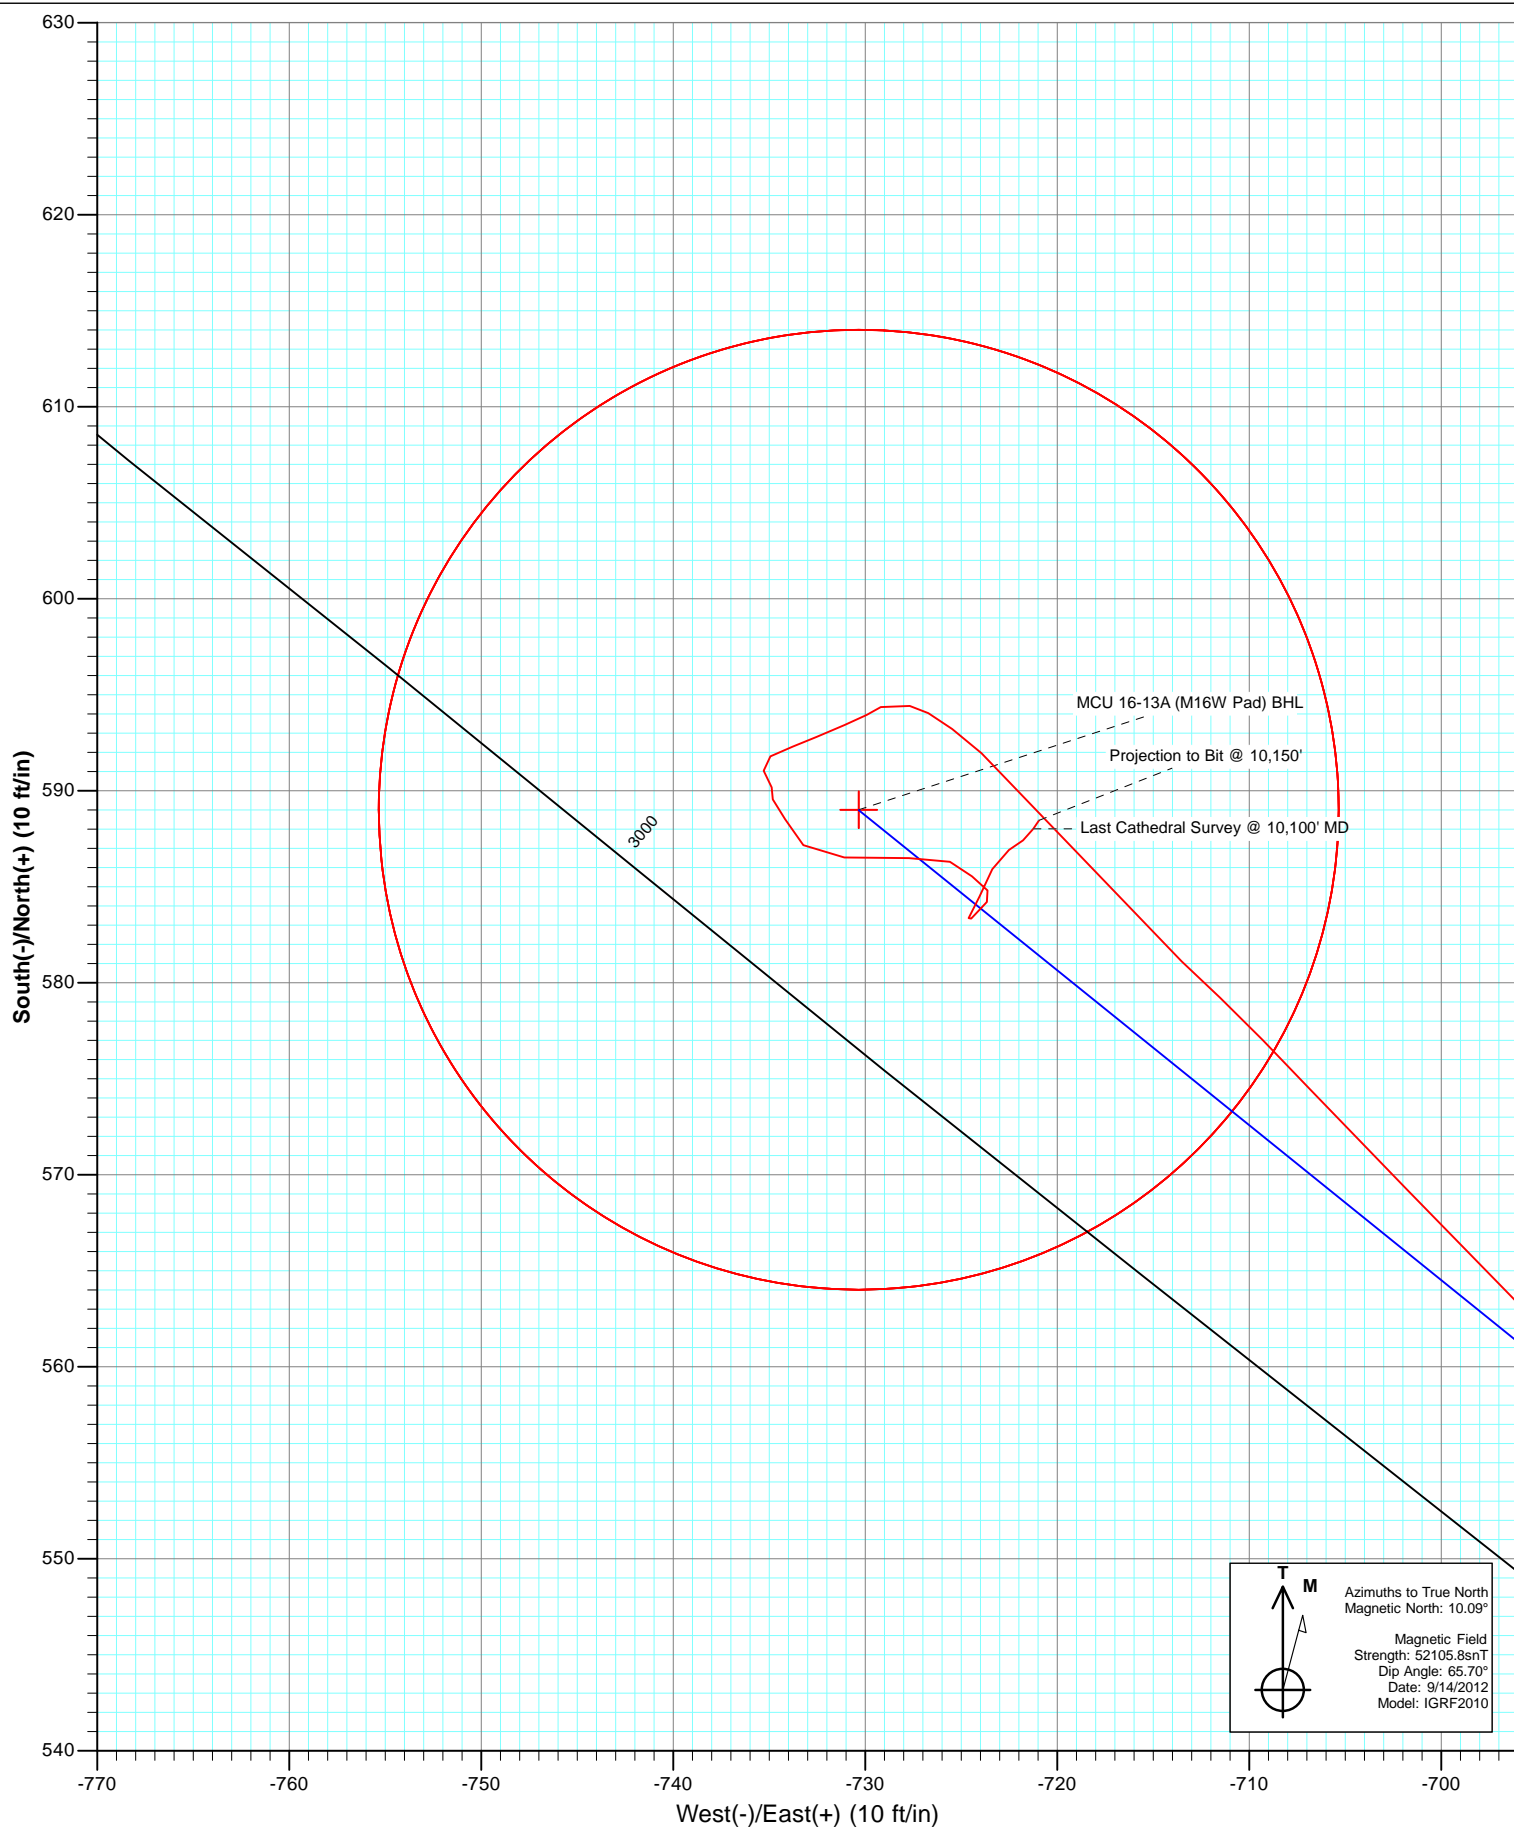

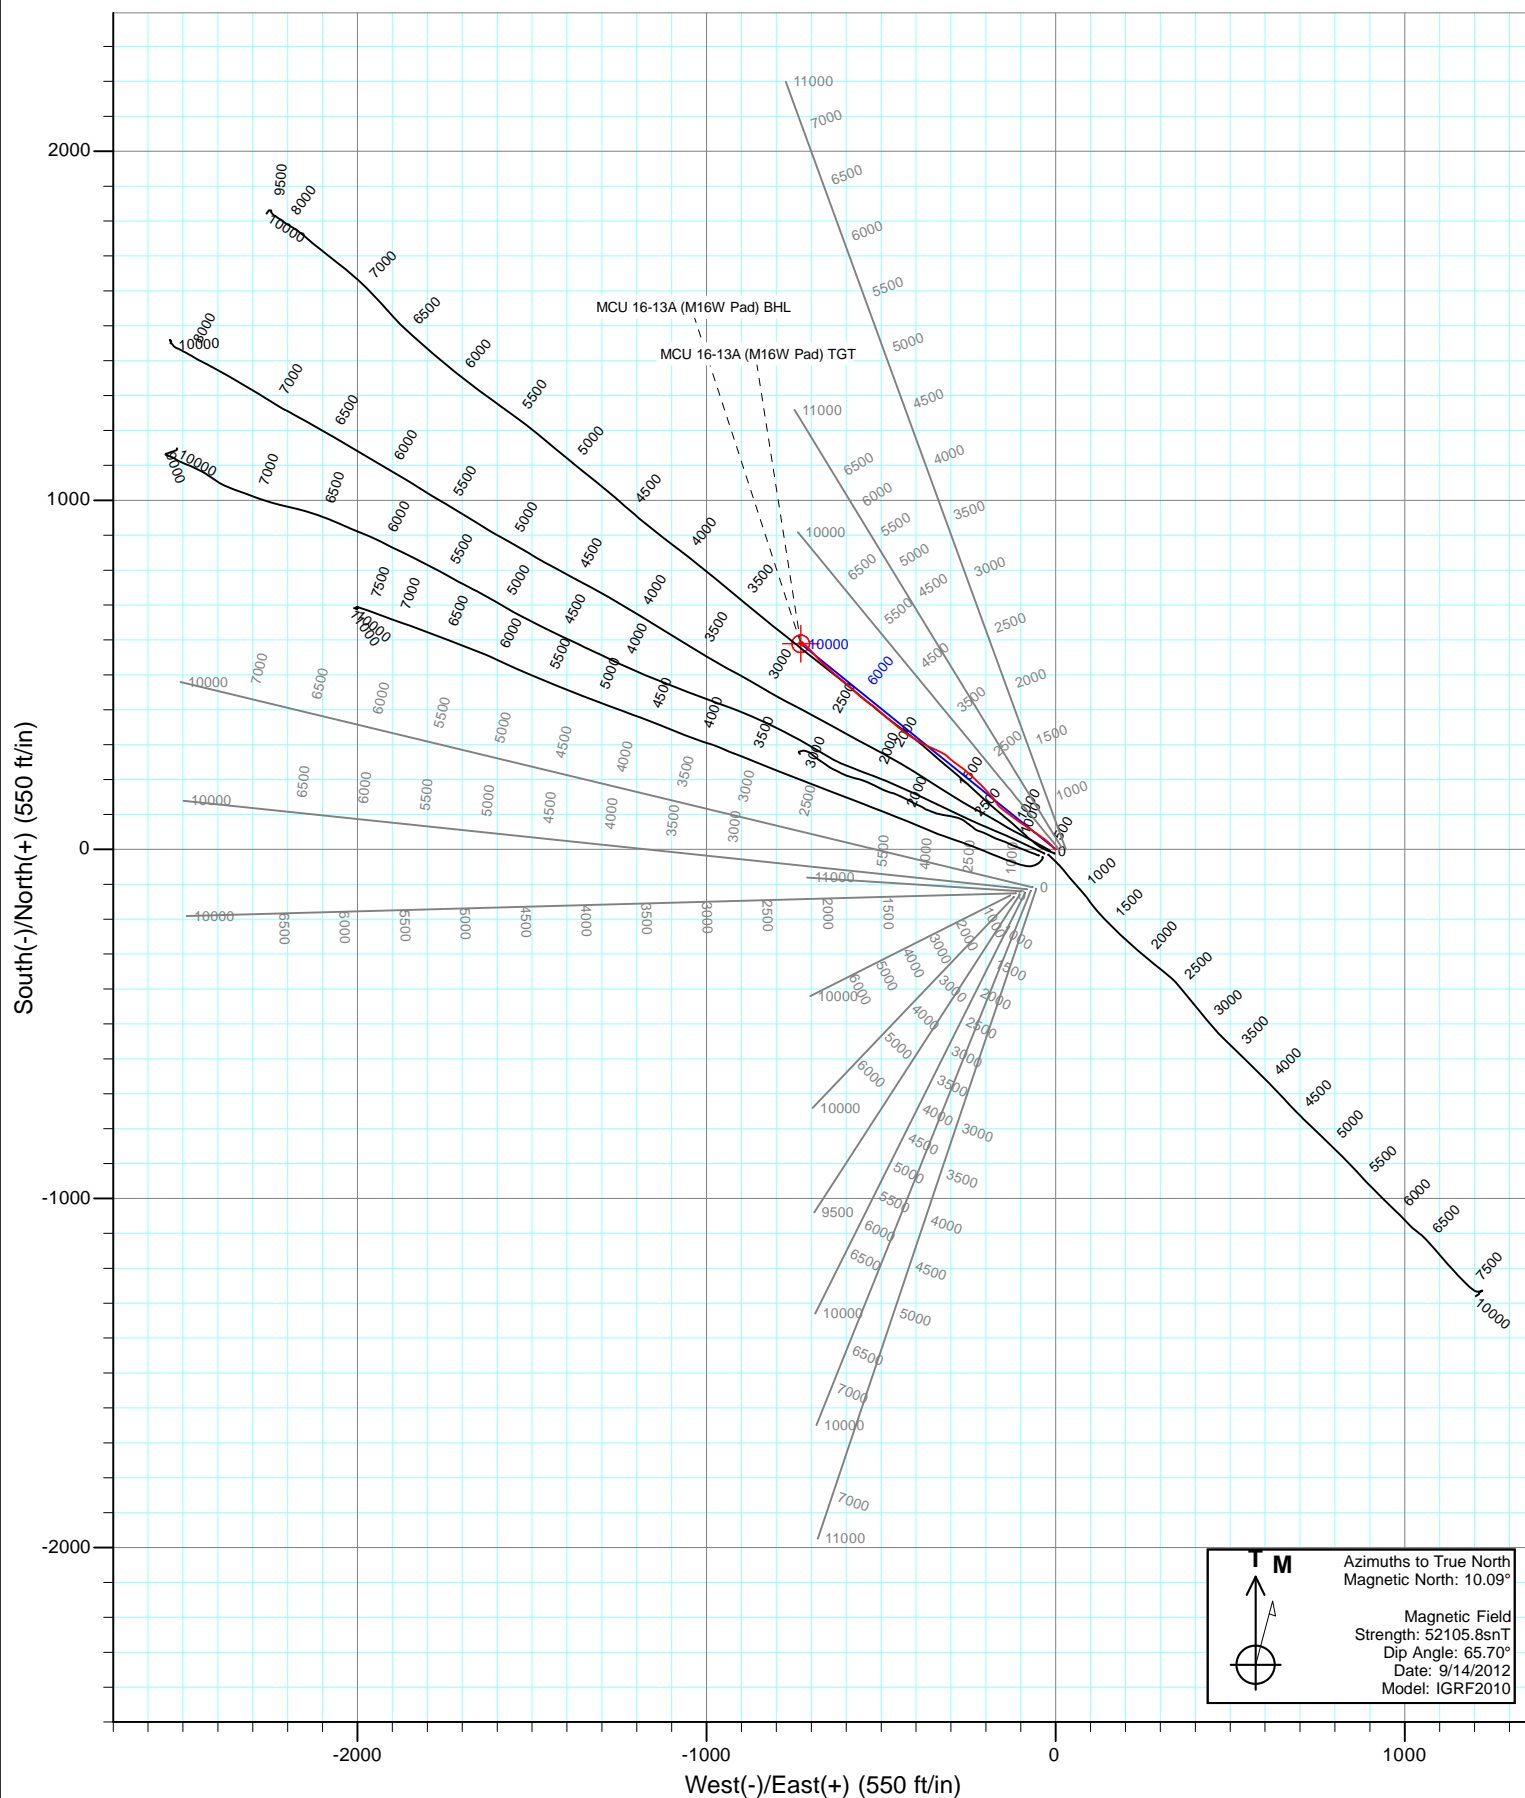

Cathedral Energy Services

Survey Report

Company:	EnCana Oil & Gas (USA) Inc	Local Co-ordinate Reference:	Well MCU 16-13A (M16W Pad)
Project:	Mamm Creek	TVD Reference:	KBE @ 7903.0ft (Patterson #308)
Site:	M16W Pad (SWSW S16-T7S-R93W)	MD Reference:	KBE @ 7903.0ft (Patterson #308)
Well:	MCU 16-13A (M16W Pad)	North Reference:	True
Wellbore:	DD	Survey Calculation Method:	Minimum Curvature
Design:	DD	Database:	USA EDM 5000 Multi Users DB

Project	Mamm Creek		
Map System:	US State Plane 1983	System Datum:	Mean Sea Level
Geo Datum:	North American Datum 1983		
Map Zone:	Colorado Central Zone		

Site	M16W Pad (SWSW S16-T7S-R93W)			
Site Position:		Northing:	1,593,196.15 ft	Latitude: 39.439834
From:	Lat/Long	Easting:	2,355,193.71 ft	Longitude: -107.783358
Position Uncertainty:	0.0 ft	Slot Radius:	13.200 in	Grid Convergence: -1.44 °

Well	MCU 16-13A (M16W Pad)			
Well Position	+N/-S	0.0 ft	Northing:	1,593,323.89 ft
	+E/-W	0.0 ft	Easting:	2,355,300.32 ft
Position Uncertainty	0.0 ft	Wellhead Elevation:	ft	Ground Level: 7,881.0 ft

Wellbore	DD				
Magnetics	Model Name	Sample Date	Declination (°)	Dip Angle (°)	Field Strength (nT)
	IGRF2010	9/14/2012	10.09	65.70	52,106

Design	DD			
Audit Notes:				
Version:	1.0	Phase:	ACTUAL	Tie On Depth: 0.0
Vertical Section:	Depth From (TVD)	+N/-S (ft)	+E/-W (ft)	Direction (°)
	0.0	0.0	0.0	308.89

Survey Program	Date	9/24/2012		
From (ft)	To (ft)	Survey (Wellbore)	Tool Name	Description
206.0	10,150.0	Survey #1 (DD)	MWD	Geolink MWD

Survey									
Measured Depth (ft)	Inclination (°)	Azimuth (°)	Vertical Depth (ft)	+N/-S (ft)	+E/-W (ft)	Vertical Section (ft)	Dogleg Rate (°/100ft)	Build Rate (°/100ft)	Formations / Comments
0.0	0.00	0.00	0.0	0.0	0.0	0.0	0.00	0.00	
206.0	0.40	283.90	206.0	0.2	-0.7	0.7	0.19	0.19	
237.0	0.50	269.50	237.0	0.2	-0.9	0.9	0.48	0.32	
267.0	0.50	295.20	267.0	0.3	-1.2	1.1	0.74	0.00	
298.0	1.20	307.80	298.0	0.5	-1.6	1.5	2.32	2.26	
328.0	1.60	320.50	328.0	1.0	-2.1	2.3	1.68	1.33	
359.0	2.50	318.60	359.0	1.9	-2.8	3.4	2.91	2.90	
389.0	3.40	309.60	388.9	2.9	-3.9	4.9	3.37	3.00	
480.0	6.40	316.80	479.6	8.3	-9.5	12.6	3.36	3.30	
571.0	7.10	317.10	570.0	16.2	-16.8	23.2	0.77	0.77	
663.0	7.90	311.90	661.2	24.5	-25.4	35.1	1.14	0.87	
755.0	8.70	302.40	752.2	32.5	-35.9	48.4	1.72	0.87	
846.0	8.80	303.80	842.1	40.1	-47.5	62.1	0.26	0.11	

Cathedral Energy Services

Survey Report

Company:	EnCana Oil & Gas (USA) Inc	Local Co-ordinate Reference:	Well MCU 16-13A (M16W Pad)
Project:	Mamm Creek	TVD Reference:	KBE @ 7903.0ft (Patterson #308)
Site:	M16W Pad (SWSW S16-T7S-R93W)	MD Reference:	KBE @ 7903.0ft (Patterson #308)
Well:	MCU 16-13A (M16W Pad)	North Reference:	True
Wellbore:	DD	Survey Calculation Method:	Minimum Curvature
Design:	DD	Database:	USA EDM 5000 Multi Users DB

Survey									
Measured Depth (ft)	Inclination (°)	Azimuth (°)	Vertical Depth (ft)	+N/-S (ft)	+E/-W (ft)	Vertical Section (ft)	Dogleg Rate (°/100ft)	Build Rate (°/100ft)	Formations / Comments
937.0	8.40	303.80	932.1	47.6	-58.8	75.7	0.44	-0.44	
1,032.0	8.30	305.20	1,026.1	55.4	-70.2	89.5	0.24	-0.11	
1,115.0	8.30	305.40	1,108.2	62.4	-80.0	101.4	0.03	0.00	
1,165.0	7.90	307.20	1,157.7	66.5	-85.7	108.4	0.95	-0.80	
1,257.0	8.00	304.20	1,248.9	74.0	-96.0	121.1	0.46	0.11	
1,349.0	7.90	302.20	1,340.0	80.9	-106.6	133.8	0.32	-0.11	
1,440.0	7.10	307.90	1,430.2	87.7	-116.4	145.6	1.20	-0.88	
1,532.0	7.40	308.70	1,521.5	94.9	-125.5	157.3	0.34	0.33	
1,623.0	7.60	305.10	1,611.7	102.0	-135.0	169.1	0.56	0.22	
1,715.0	7.30	308.10	1,702.9	109.1	-144.6	181.0	0.53	-0.33	
1,806.0	7.20	305.10	1,793.2	116.0	-153.8	192.5	0.43	-0.11	
1,898.0	6.50	320.30	1,884.5	123.3	-161.8	203.4	2.10	-0.76	
1,989.0	6.90	324.40	1,974.9	131.7	-168.3	213.7	0.68	0.44	
2,081.0	7.30	322.50	2,066.2	140.8	-175.1	224.7	0.50	0.43	
2,173.0	8.80	320.40	2,157.3	150.9	-183.1	237.3	1.66	1.63	
2,264.0	8.20	316.60	2,247.3	161.0	-192.0	250.5	0.90	-0.66	
2,356.0	8.20	315.10	2,338.4	170.4	-201.1	263.5	0.23	0.00	
2,447.0	8.00	316.80	2,428.4	179.6	-210.1	276.3	0.34	-0.22	
2,539.0	7.30	320.60	2,519.6	188.8	-218.1	288.3	0.94	-0.76	
2,630.0	8.60	312.20	2,609.8	197.8	-226.9	300.8	1.91	1.43	
2,722.0	7.90	310.40	2,700.8	206.5	-236.8	314.0	0.81	-0.76	
2,813.0	7.90	310.70	2,790.9	214.7	-246.3	326.5	0.05	0.00	
2,905.0	7.70	311.70	2,882.1	222.9	-255.7	338.9	0.26	-0.22	
2,996.0	7.80	308.90	2,972.3	230.8	-265.0	351.2	0.43	0.11	
3,088.0	7.70	305.00	3,063.4	238.3	-274.9	363.6	0.58	-0.11	
3,179.0	7.30	306.70	3,153.6	245.2	-284.6	375.5	0.50	-0.44	
3,271.0	7.20	307.40	3,244.9	252.2	-293.8	387.1	0.15	-0.11	
3,362.0	7.20	311.40	3,335.2	259.5	-302.6	398.5	0.55	0.00	
3,454.0	6.80	312.40	3,426.5	267.0	-311.0	409.7	0.45	-0.43	
3,546.0	8.10	301.20	3,517.7	274.0	-320.5	421.5	2.11	1.41	
3,637.0	8.00	295.60	3,607.8	280.0	-331.7	434.0	0.87	-0.11	
3,728.0	8.30	296.00	3,697.9	285.7	-343.4	446.6	0.34	0.33	
3,820.0	8.00	293.90	3,789.0	291.2	-355.2	459.3	0.46	-0.33	
3,911.0	7.30	294.00	3,879.2	296.1	-366.3	471.0	0.77	-0.77	
4,002.0	7.10	297.90	3,969.5	301.1	-376.5	482.1	0.58	-0.22	
4,094.0	6.70	294.00	4,060.8	305.9	-386.4	492.8	0.67	-0.43	
4,185.0	8.40	303.70	4,151.0	311.8	-396.8	504.6	2.33	1.87	
4,277.0	8.10	301.50	4,242.1	318.9	-407.9	517.7	0.47	-0.33	
4,368.0	8.00	305.10	4,332.2	325.9	-418.6	530.4	0.56	-0.11	
4,460.0	8.10	303.90	4,423.2	333.2	-429.2	543.2	0.21	0.11	
4,551.0	7.70	308.30	4,513.4	340.5	-439.3	555.7	0.80	-0.44	
4,643.0	7.40	309.90	4,604.6	348.1	-448.7	567.8	0.40	-0.33	
4,734.0	7.10	308.00	4,694.9	355.4	-457.6	579.3	0.42	-0.33	
4,826.0	6.90	310.30	4,786.2	362.4	-466.3	590.5	0.37	-0.22	
4,917.0	7.00	312.30	4,876.5	369.7	-474.6	601.5	0.29	0.11	
5,009.0	7.00	309.20	4,967.8	377.0	-483.1	612.7	0.41	0.00	
5,100.0	6.80	311.40	5,058.2	384.1	-491.4	623.6	0.36	-0.22	
5,192.0	6.80	313.00	5,149.5	391.4	-499.5	634.5	0.21	0.00	
5,284.0	6.60	309.40	5,240.9	398.5	-507.5	645.2	0.51	-0.22	
5,375.0	6.90	309.50	5,331.3	405.3	-515.8	655.9	0.33	0.33	
5,467.0	6.50	305.90	5,422.6	411.8	-524.3	666.6	0.63	-0.43	
5,558.0	6.60	308.00	5,513.0	418.1	-532.6	677.0	0.29	0.11	
5,650.0	6.20	305.00	5,604.5	424.2	-540.8	687.3	0.57	-0.43	

Cathedral Energy Services

Survey Report

Company:	EnCana Oil & Gas (USA) Inc	Local Co-ordinate Reference:	Well MCU 16-13A (M16W Pad)
Project:	Mamm Creek	TVD Reference:	KBE @ 7903.0ft (Patterson #308)
Site:	M16W Pad (SWSW S16-T7S-R93W)	MD Reference:	KBE @ 7903.0ft (Patterson #308)
Well:	MCU 16-13A (M16W Pad)	North Reference:	True
Wellbore:	DD	Survey Calculation Method:	Minimum Curvature
Design:	DD	Database:	USA EDM 5000 Multi Users DB

Survey									
Measured Depth (ft)	Inclination (°)	Azimuth (°)	Vertical Depth (ft)	+N/-S (ft)	+E/-W (ft)	Vertical Section (ft)	Dogleg Rate (°/100ft)	Build Rate (°/100ft)	Formations / Comments
5,741.0	8.50	304.00	5,694.7	430.8	-550.4	698.9	2.53	2.53	
5,833.0	8.00	311.50	5,785.8	438.8	-560.8	712.0	1.29	-0.54	
5,924.0	8.00	312.00	5,875.9	447.2	-570.3	724.7	0.08	0.00	
6,016.0	8.00	314.00	5,967.0	456.0	-579.7	737.4	0.30	0.00	
6,108.0	7.80	313.40	6,058.1	464.7	-588.8	750.0	0.24	-0.22	
6,199.0	7.80	310.30	6,148.3	472.9	-598.0	762.4	0.46	0.00	
6,290.0	7.50	310.20	6,238.5	480.8	-607.2	774.5	0.33	-0.33	
6,382.0	6.90	309.80	6,329.7	488.2	-616.1	786.0	0.65	-0.65	
6,473.0	6.80	308.70	6,420.1	495.0	-624.5	796.9	0.18	-0.11	
6,565.0	6.30	309.50	6,511.5	501.7	-632.6	807.4	0.55	-0.54	
6,657.0	5.90	313.90	6,603.0	508.2	-639.9	817.1	0.67	-0.43	
6,748.0	5.60	309.40	6,693.5	514.2	-646.7	826.2	0.59	-0.33	
6,840.0	5.20	313.70	6,785.1	519.9	-653.2	834.9	0.62	-0.43	
6,932.0	4.90	307.90	6,876.7	525.2	-659.3	842.9	0.64	-0.33	
7,024.0	5.80	314.40	6,968.3	530.9	-665.7	851.5	1.18	0.98	
7,115.0	6.30	317.40	7,058.8	537.8	-672.4	861.0	0.65	0.55	
7,207.0	5.60	313.80	7,150.3	544.6	-679.1	870.5	0.86	-0.76	
7,299.0	7.70	320.60	7,241.7	552.5	-686.2	881.0	2.43	2.28	
7,390.0	7.00	316.10	7,332.0	561.2	-693.9	892.5	1.00	-0.77	
7,482.0	7.00	315.30	7,423.3	569.2	-701.8	903.6	0.11	0.00	
7,543.0	6.90	316.60	7,483.8	574.5	-706.9	910.9	0.31	-0.16	
7,634.0	4.90	312.60	7,574.3	581.1	-713.5	920.2	2.24	-2.20	
7,725.0	4.90	319.60	7,665.0	586.7	-718.9	927.9	0.66	0.00	
7,817.0	4.20	311.90	7,756.7	592.0	-723.9	935.1	1.01	-0.76	
7,908.0	1.60	281.00	7,847.6	594.4	-727.7	939.6	3.24	-2.86	
8,000.0	0.50	218.80	7,939.6	594.4	-729.2	940.7	1.56	-1.20	
8,092.0	0.60	258.50	8,031.6	594.0	-729.9	941.0	0.42	0.11	
8,184.0	1.00	238.70	8,123.6	593.4	-731.1	941.6	0.52	0.43	
8,275.0	1.00	254.30	8,214.6	592.8	-732.5	942.3	0.30	0.00	
8,367.0	0.70	239.00	8,306.5	592.3	-733.8	943.0	0.41	-0.33	
8,459.0	0.90	252.50	8,398.5	591.8	-734.9	943.6	0.30	0.22	
8,550.0	0.80	148.50	8,489.5	591.0	-735.3	943.4	1.47	-0.11	
8,642.0	0.40	165.40	8,581.5	590.2	-734.9	942.5	0.47	-0.43	
8,733.0	0.40	182.20	8,672.5	589.6	-734.8	942.1	0.13	0.00	
8,825.0	1.20	137.80	8,764.5	588.5	-734.2	940.9	1.04	0.87	
8,916.0	0.90	154.50	8,855.5	587.2	-733.2	939.3	0.47	-0.33	
9,007.0	2.30	89.70	8,946.5	586.5	-731.1	937.3	2.29	1.54	
9,099.0	1.90	91.90	9,038.4	586.5	-727.7	934.6	0.44	-0.43	
9,190.0	0.80	103.30	9,129.4	586.3	-725.6	932.9	1.24	-1.21	
9,282.0	1.00	138.70	9,221.4	585.5	-724.4	931.5	0.63	0.22	
9,373.0	0.40	115.60	9,312.4	584.8	-723.6	930.4	0.72	-0.66	
9,465.0	0.70	215.00	9,404.4	584.2	-723.7	930.0	0.94	0.33	
9,557.0	0.80	230.40	9,496.4	583.3	-724.5	930.1	0.24	0.11	
9,648.0	0.70	39.50	9,587.3	583.4	-724.6	930.3	1.64	-0.11	
9,740.0	0.90	17.00	9,679.3	584.5	-724.0	930.5	0.40	0.22	
9,831.0	1.10	31.30	9,770.3	585.9	-723.4	930.9	0.35	0.22	
9,923.0	0.60	59.30	9,862.3	586.9	-722.5	930.9	0.69	-0.54	
10,015.0	0.50	50.90	9,954.3	587.4	-721.8	930.6	0.14	-0.11	
10,100.0	0.60	34.20	10,039.3	588.0	-721.2	930.6	0.22	0.12	Last Cathedral Survey @ 10,100' MD
10,150.0	0.60	34.20	10,089.3	588.5	-720.9	930.6	0.00	0.00	Projection to Bit @ 10,150'

Cathedral Energy Services

Survey Report

Company:	EnCana Oil & Gas (USA) Inc	Local Co-ordinate Reference:	Well MCU 16-13A (M16W Pad)
Project:	Mamm Creek	TVD Reference:	KBE @ 7903.0ft (Patterson #308)
Site:	M16W Pad (SWSW S16-T7S-R93W)	MD Reference:	KBE @ 7903.0ft (Patterson #308)
Well:	MCU 16-13A (M16W Pad)	North Reference:	True
Wellbore:	DD	Survey Calculation Method:	Minimum Curvature
Design:	DD	Database:	USA EDM 5000 Multi Users DB

Targets									
Target Name									
- hit/miss target	Dip Angle	Dip Dir.	TVD	+N/-S	+E/-W	Northing	Easting	Latitude	Longitude
- Shape	(°)	(°)	(ft)	(ft)	(ft)	(ft)	(ft)		
MCU 16-13A (M16W Pa	0.00	0.00	7,868.0	589.0	-730.3	1,593,931.07	2,354,585.02	39.441809	-107.785578
- survey misses target center by 5.9ft at 7928.4ft MD (7868.0 TVD, 594.5 N, -728.2 E)									
- Circle (radius 25.0)									
MCU 16-13A (M16W Pa	0.00	0.00	9,984.0	589.0	-730.3	1,593,931.07	2,354,585.02	39.441809	-107.785578
- survey misses target center by 8.9ft at 10044.6ft MD (9984.0 TVD, 587.6 N, -721.6 E)									
- Circle (radius 25.0)									

Survey Annotations				
Measured Depth	Vertical Depth	Local Coordinates		Comment
(ft)	(ft)	+N/-S (ft)	+E/-W (ft)	
10,100.0	10,039.3	588.0	-721.2	Last Cathedral Survey @ 10,100' MD
10,150.0	10,089.3	588.5	-720.9	Projection to Bit @ 10,150'

Checked By: _____ Approved By: _____ Date: _____