


SPU- 1294-23-41D-H1-R1

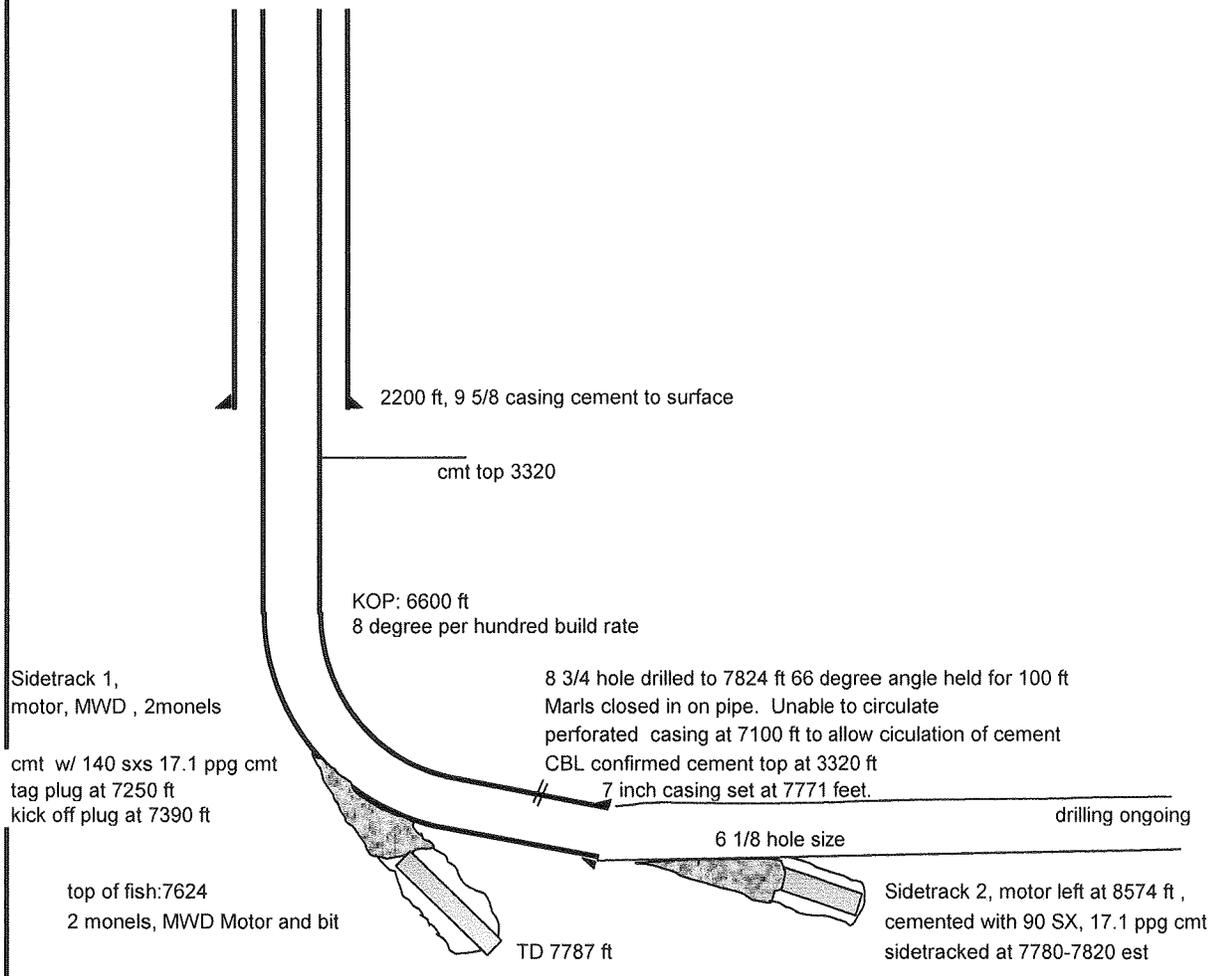

Sidetrack 1,
motor, MWD , 2monels

cmt w/ 140 sxs 17.1 ppg cmt
tag plug at 7250 ft
kick off plug at 7390 ft

top of fish:7624
2 monels, MWD Motor and bit

2200 ft, 9 5/8 casing cement to surface

cmt top 3320

KOP: 6600 ft
8 degree per hundred build rate

8 3/4 hole drilled to 7824 ft 66 degree angle held for 100 ft
Marls closed in on pipe. Unable to circulate
perforated casing at 7100 ft to allow circulation of cement
CBL confirmed cement top at 3320 ft

7 inch casing set at 7771 feet.

6 1/8 hole size

drilling ongoing

TD 7787 ft

Sidetrack 2, motor left at 8574 ft ,
cemented with 90 SX, 17.1 ppg cmt
sidetracked at 7780-7820 est