

Location Drawing


Smith Energy Corp

API# 05-121-10756

Hickert 33-20349

NESE Section 20 T3S-R49W, 6th pm

(2320'FSL, 1340'FEL)

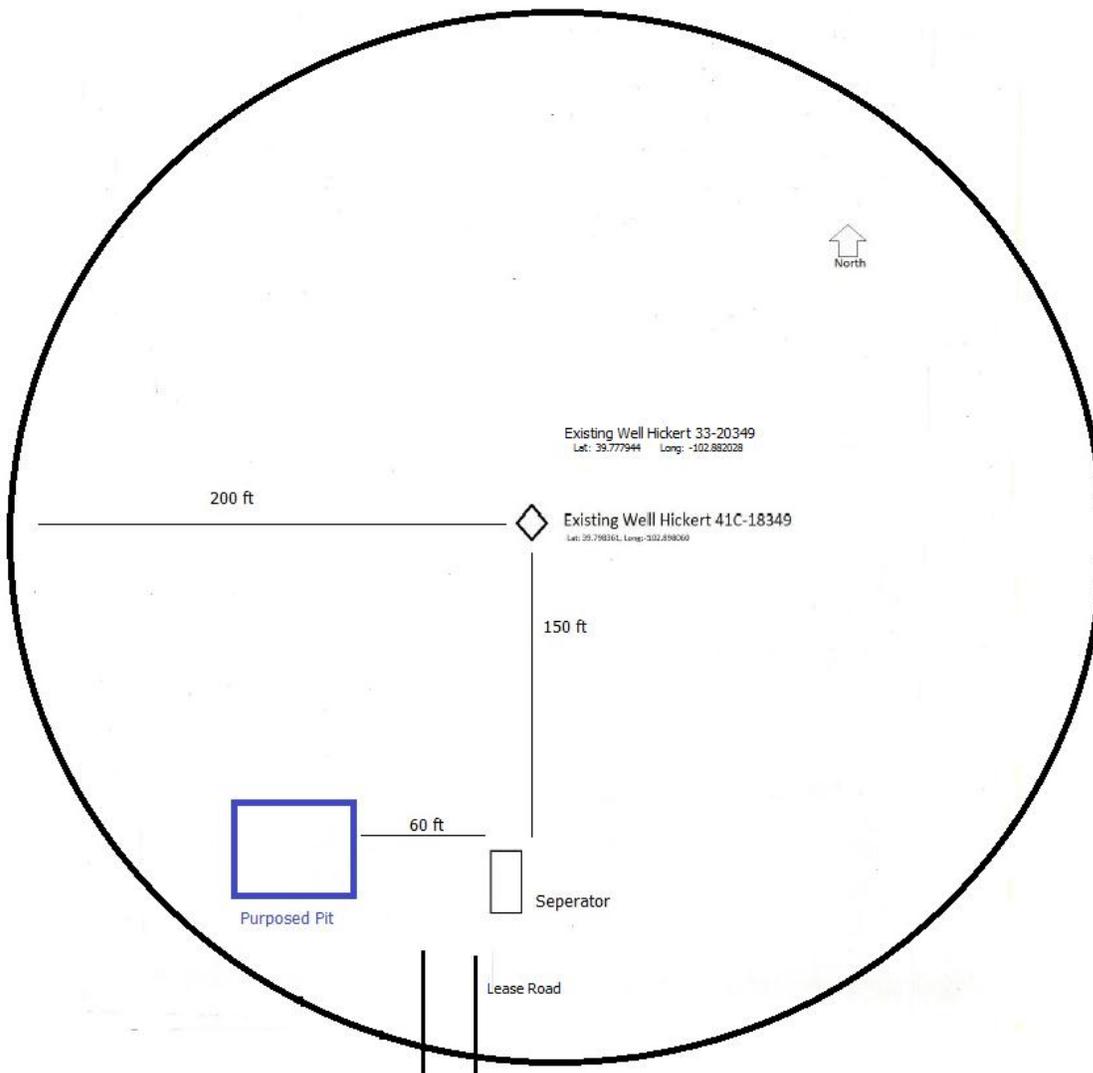

Note: There have been no improvements within the 400 ft radius, the only improvement will be the purposed pit.