

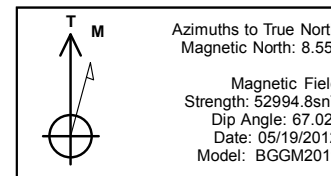


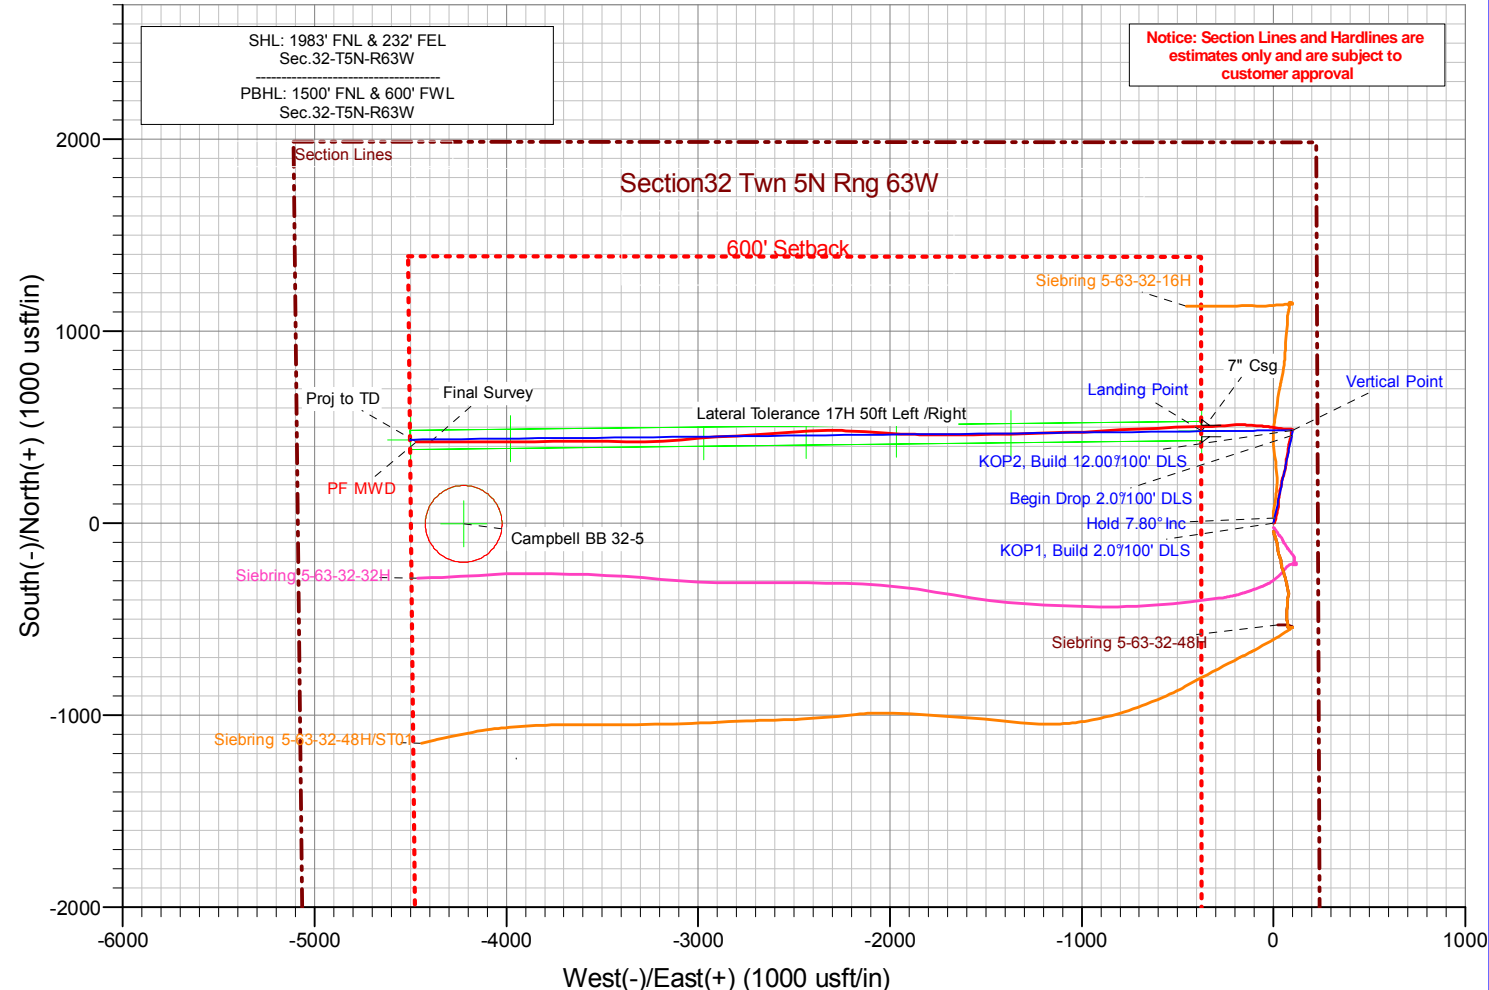

PATHFINDER
A Schlumberger Company

WELLBORE TARGET DETAILS						
Name	TVD	+N/-S	+E/-W	Latitude	Longitude	Shape
1408' VS 6443 TVD	6443.00	468.56	-1369.26	40°21' 32.78 2 N	104°27' 22.24 W	Point
2000' VS 6445' TVD	6445.00	462.26	-1964.65	40°21' 32.7 19 N	104°27' 29.916 W	Point
3000' VS 6460' TVD	6460.00	451.62	-2970.34	40°21' 32.6 13 N	104°27' 42.907 W	Point
4000' VS 6476' TVD	6476.00	440.96	-3976.01	40°21' 32.5 06 N	104°27' 55.899 W	Point
Campbell BB 32-5	0.00	-3.27	-4222.06	40°21' 28.116 N	104°27' 59.076 W	
Lateral Loebling 17H	6.00	457.23	-2437.62	40°21' 32.6 69 N	104°27' 36.025 W	
LP - Siebring 5-63-32-17H	6434.00	479.06	-375.59	40°21' 32.886 N	104°27' 9.388 W	Point
PBHL Siebring 5-63-32-17H	6449.00	435.41	-4499.65	40°2 1' 32.451 N	104°28' 2.663 W	Point

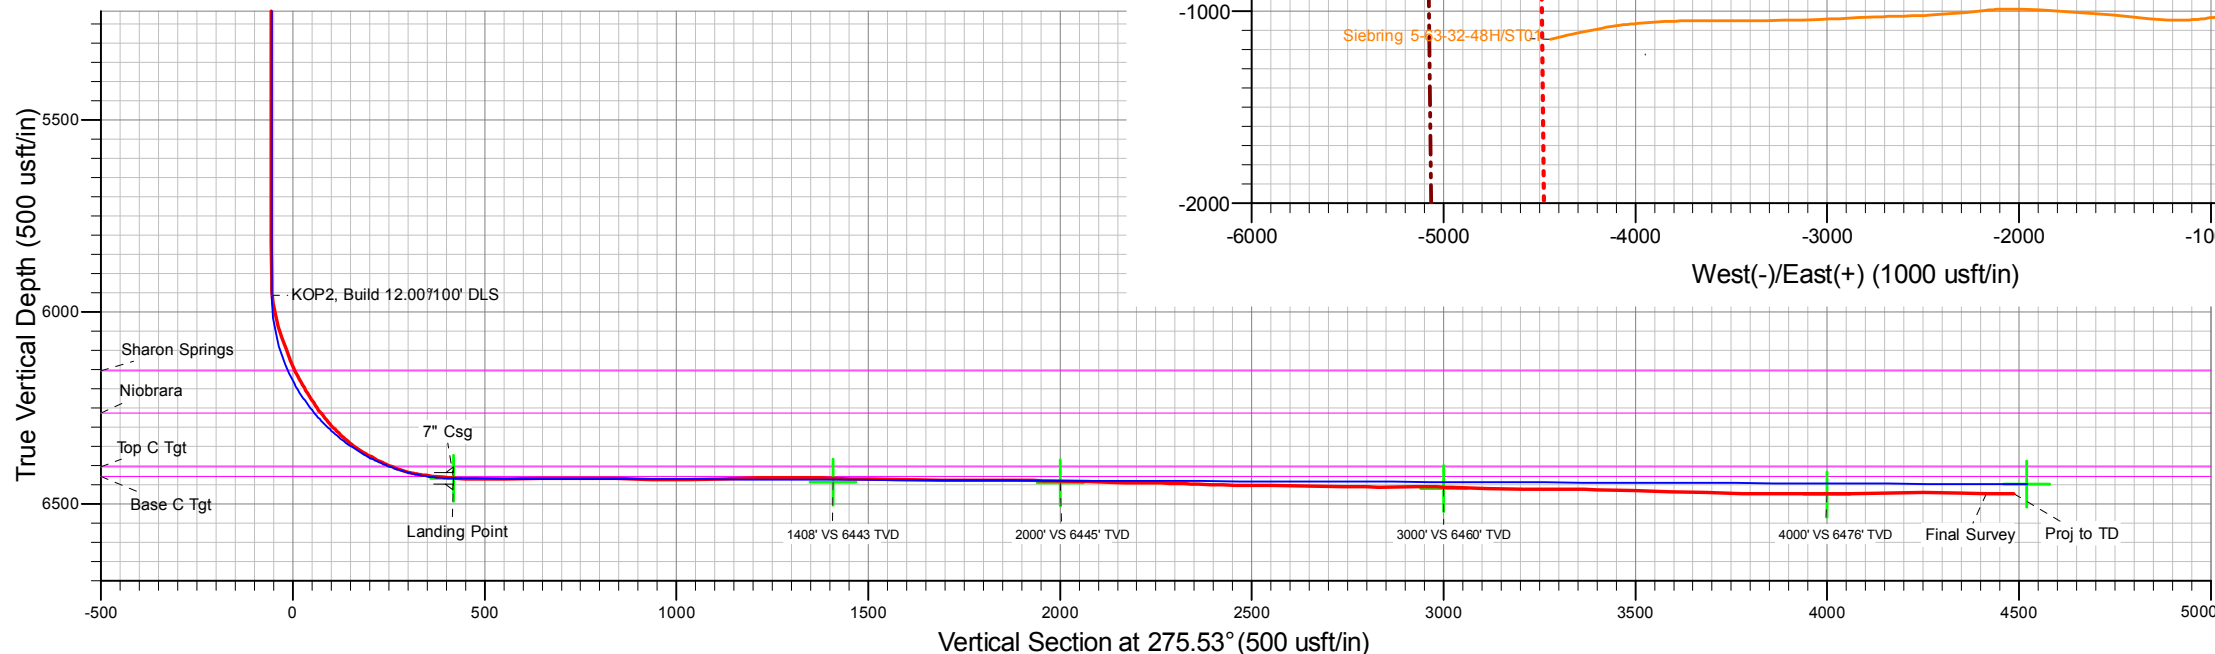

Plan: Rev 1 (Siebring 5-63-32-17H/Original Hole)
Created By: KWong Date: 7:23, July 23 2012