


Current Wellbore Schematic
EnCana Oil & Gas (USA) Inc.



WELL : Melbon Ranch 3B-17H
LOCATION : Lat: 40.134988 Long: -104.696649
COUNTY : WELD STATE: CO
FIELD : Wattenberg - NIOBRARA
ELEVATION : 4958' (GL) 4971' (KB) Δ 13'

SPUD DATE: 3/14/12
COMPL. DATE: June, 2012
API #: 05123352280000

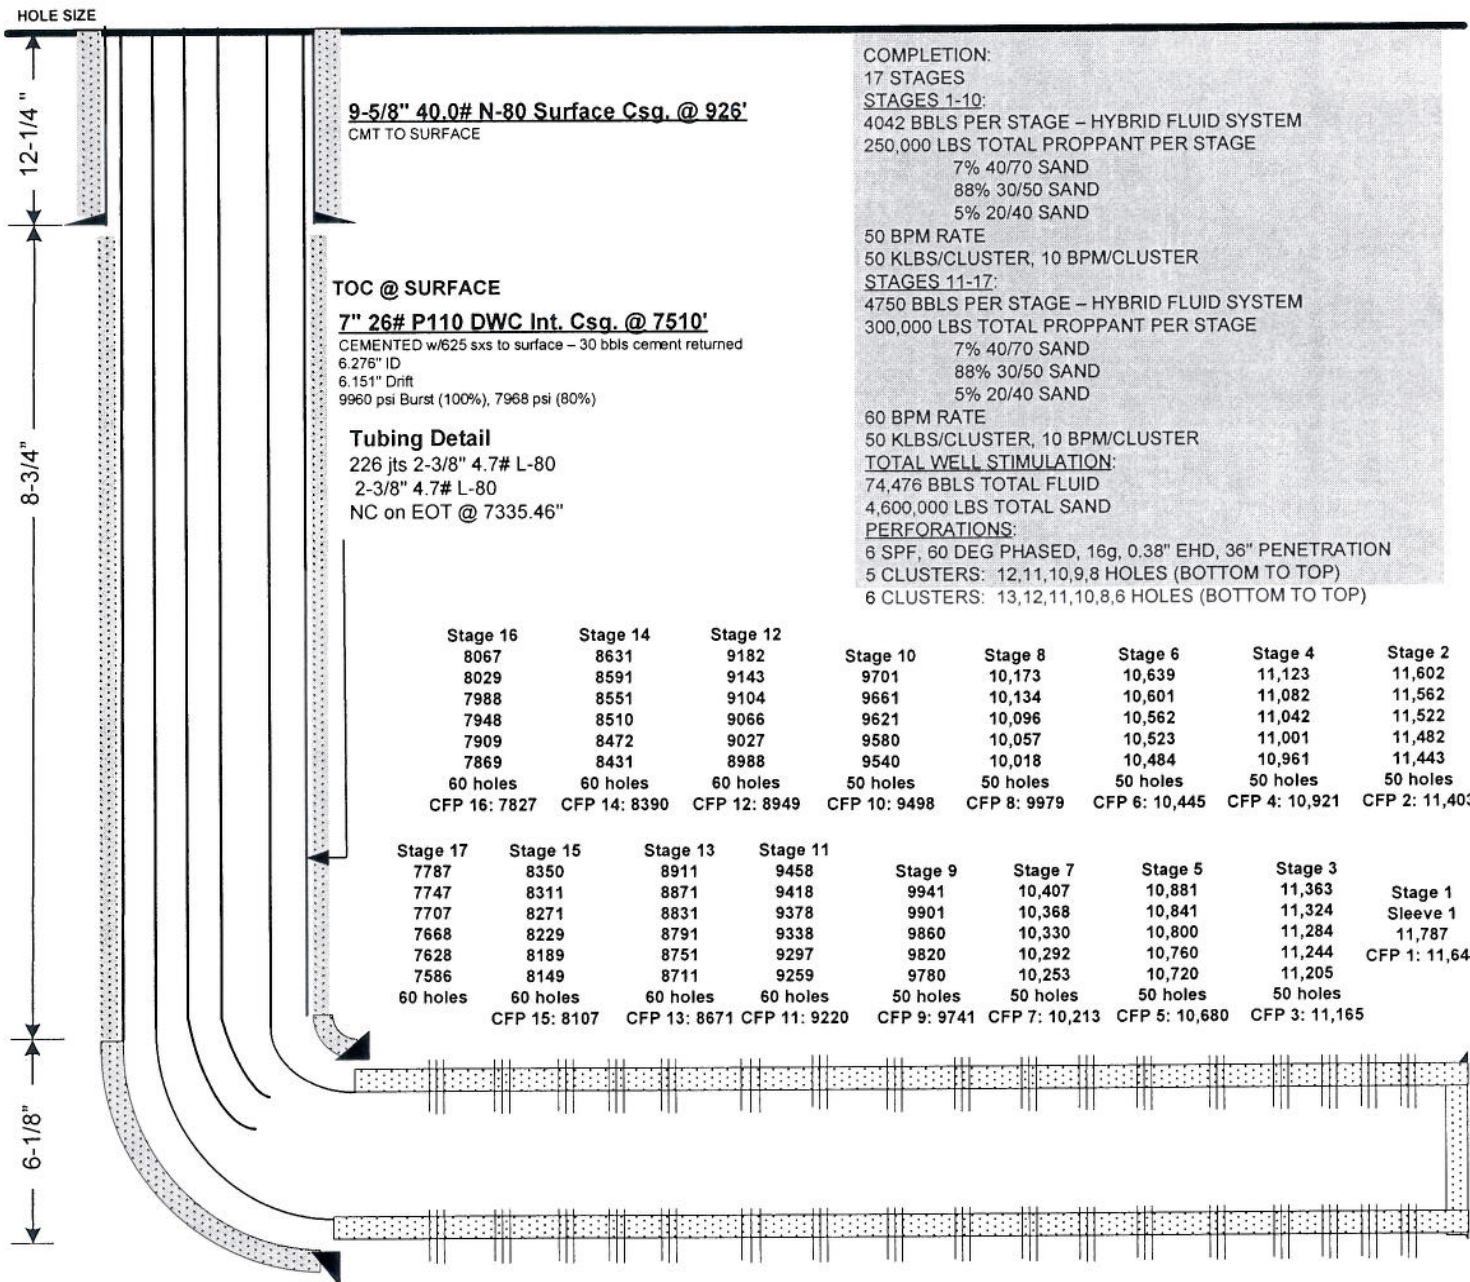

TD: 11,980'
PBSD (FC): 11,912'
TVD: 7145'
BHT 240 F