


Battle Mountain 14-15 - 12/2012

API 05-081-07432

Moffat County, Colorado

SWSE Sec 14 T12N R89W

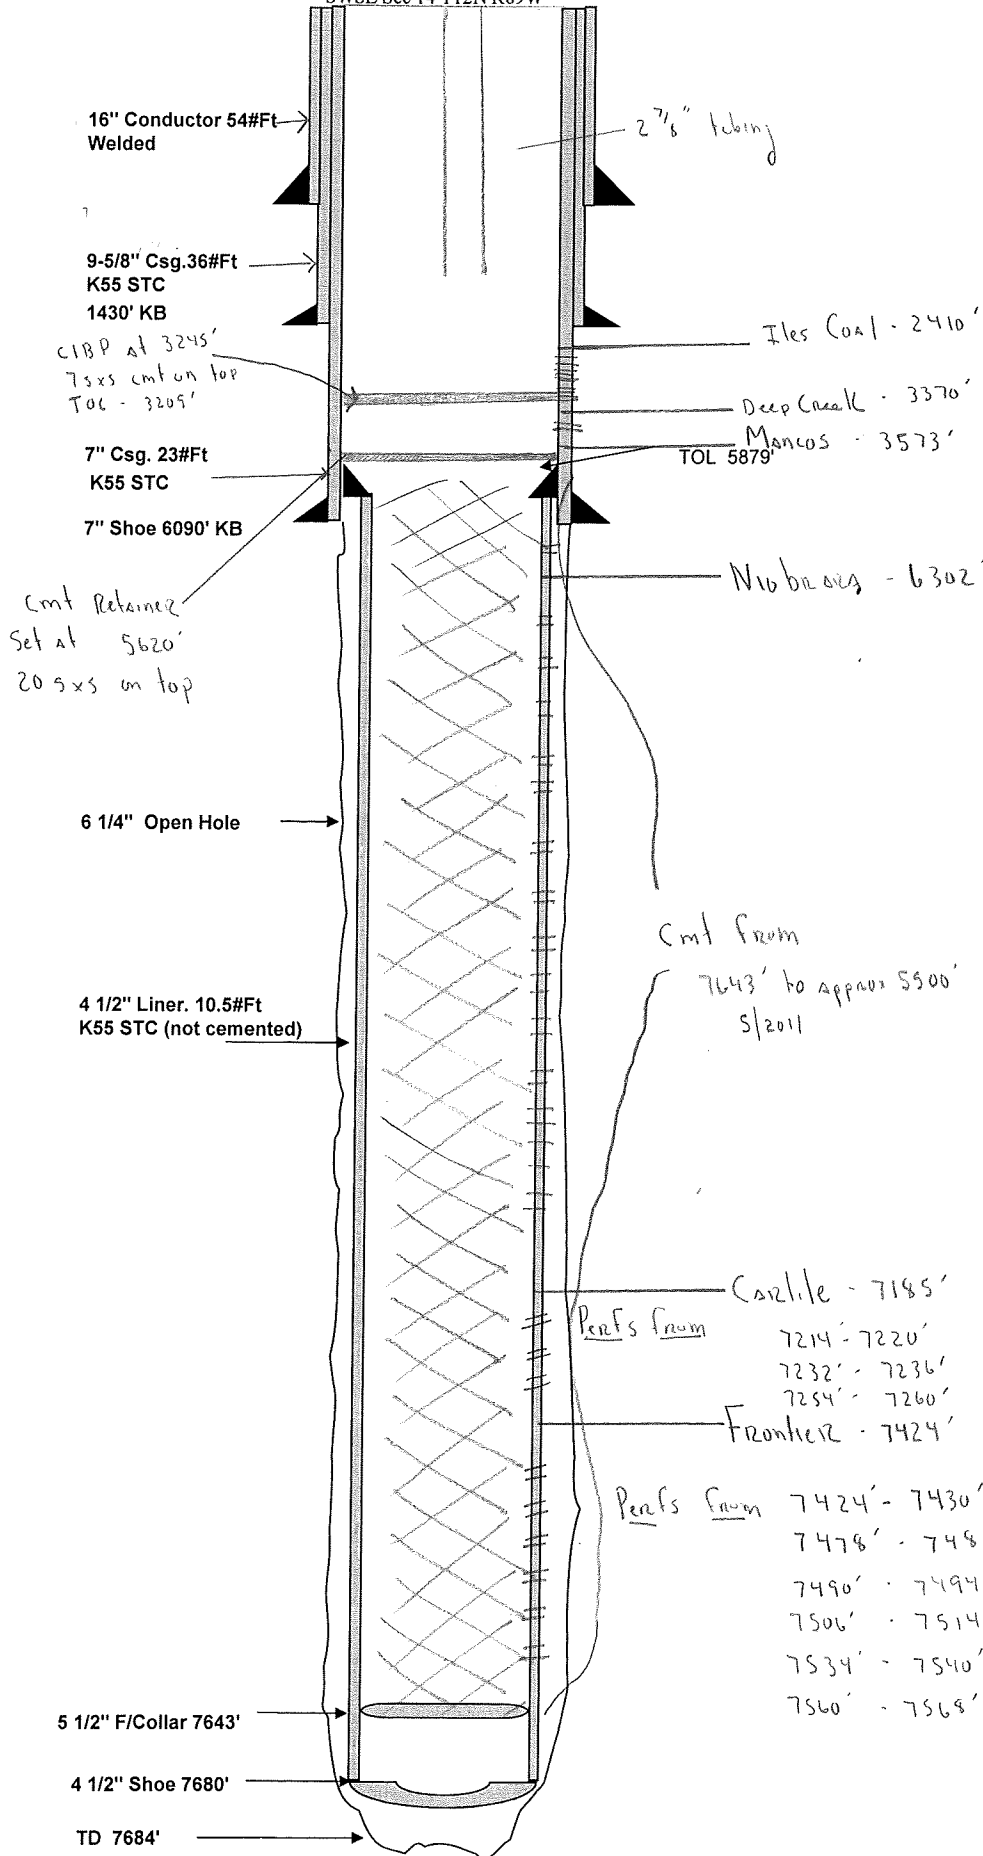

Iles Coal Perfs

2384' - 2392'	2448' - 2450'
2410' - 2414'	2464' - 2468'
2426' - 2430'	2494' - 2498'
	2512' - 2516'

Deep Creek Perfs 3372' - 3377'

Lower Mancos / Niobrara Perfs

6194' - 6196'	6763' - 6765'
6204' - 6206'	6767' - 6769'
6236' - 6232'	6770' - 6772'
6235' - 6237'	6780' - 6782'
6256' - 6252'	6783' - 6785'
6262' - 6264'	6849' - 6851'
6305' - 6307'	6856' - 6858'
6507' - 6511'	6867' - 6869'
6614' - 6618'	6882' - 6886'
6716' - 6722'	6912' - 6917'
6728' - 6736'	6936' - 6946'
6731' - 6733'	6965' - 6976'
6738' - 6740'	7008' - 7012'
6758' - 6762'	7015' - 7020'
	7033' - 7036'
	7054' - 7060'
	7070' - 7076'