


**GRAND
MESA****OPERATING COMPANY**

(316) 265-3000
FAX: (316) 265-3455

1700 N. WATERFRONT PARKWAY
BLOG, 800
WICHITA, KANSAS 67208-5514

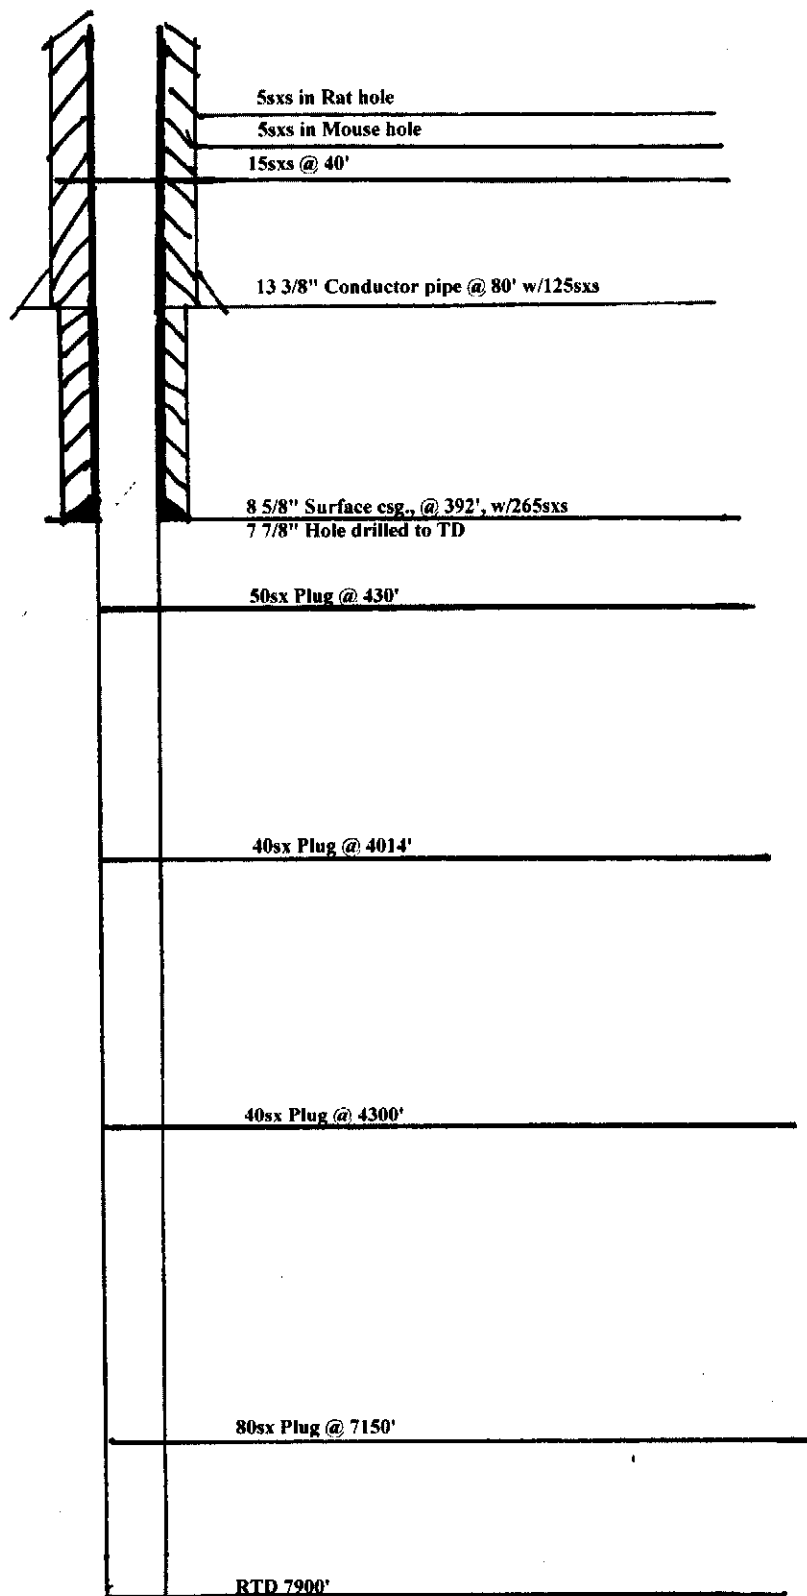

Well name: APC-Martin #1-3
Location: SE/4 Sec. 3-10S-55W
County: Lincoln
State: Colorado
API #: 05-073-06488-00
Surface csg: 8 5/8" @ 392'; 24#
Cemented w/: 265sxs Class "A"
TD: 7900' LTD: 7901'
Spud date: 11/09/2012
Comp. date: 11/29/2012
P & A date: 11/29/2012

LOG TOPS

Lansing	6602
Stark	6869
Pleasanton Sh.	6933
Excello	7106
Morrow	7566
Mississippian	7806
LTD	7901