

BMP Plan

Wiepking-Fullerton Energy, L.L.C.
4600 S. Downing St.
Englewood, CO 80113
303-789-1798
303-761-9067 (fax)

Certification to Discharge
Under
CDPS General Permit COR-03000
Stormwater Discharges Associated with Construction

Certification Number COR 39788


Raptor # 1 well
T10S, R55W
Sec. 18: SE1/4SE1/4
Lincoln County, Colorado

Description of Well Site and Construction Area

1-4 acre site with access road for drilling of oil and gas well. Terrain is rolling with native grass and sagebrush. No receiving waters will be affected by well pad. Surface Roughening on low side of drill site to reduce speed of runoff, increase infiltration, reduce erosion, trap sediment and prepare soil for reseeding. Mud and water pits will be reclaimed within 6 months weather permitting. Topsoil will be separated and spread on drill site as final operation before reseeding operations which will be completed within 6 months weather permitting. To prevent soil erosion site will be disked and straw crimped in or manure spread. Metal fence within 138' of well location will not be disturbed by drilling pad.

Stormwater Management Plan (SWMP) is on file in Wiepking-Fullerton Energy, L.L.C. office.

Spill Prevention, Control and Countermeasure Plan is on file in Wiepking-Fullerton Energy, L.L.C. office.

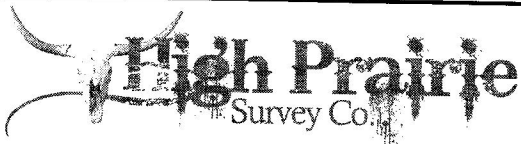

Physical Address: 401 Arapahoe St.
Mail to: Box 384 Kiowa, CO 80117
Ph. 303-621-8672 - Fax 303-621-2717
www.highprairiesurvey.com

Job: 10188 Raptor #1
Rev: 10-29-2012

Inv # 1328

High Prairie Surveying of Kiowa, Colorado has in accordance with a request from **Jack Fincham, Wiepking Fullerton Energy** has determined the location of **Raptor #1** to be **660 feet FSL**, and **660 feet FEL**, (90° off Section lines) of **SECTION 18**, Township **10s**, Range **55w** of the 6th Principal Meridian, **Lincoln County**, Colorado.

Date: Staked on 11-05-10 drawn on 11-07-10.
Rev: Moved well 10-29-12

Re: Staked by Keith Westfall
Drawn: Drawn by Elijah Frane

Topo Exhibit

