

## BMP Plan

Wiepking-Fullerton Energy, L.L.C.  
4600 S. Downing St.  
Englewood, CO 80113  
303-789-1798  
303-761-9067 (fax)

Certification to Discharge  
Under  
CDPS General Permit COR-03000  
Stormwater Discharges Associated with Construction

Certification Number COR 39788

Bubba-State # 8 well  
T10S, R55W  
Sec. 20: NE1/4SE1/4  
Lincoln County, Colorado

### Description of Well Site and Construction Area

1-4 acre site with access road for drilling of oil and gas well. Terrain is flat with native grass and sagebrush. No receiving/surface water will be affected by well pad or access road. Surface Roughening will be used on low side of drill site to reduce speed of runoff, increase infiltration, reduce erosion, trap sediment and prepare soil for reseeding. Mud and Water Pits will be reclaimed within 6 months weather permitting. Topsoil will be separated and spread on drill site as final operation before reseeding operations. To prevent soil erosion site will be disked and straw crimped in or manure spread.

Stormwater Management Plan (SWMP) is on file in Wiepking-Fullerton Energy, L.L.C. office.

Spill Prevention, Control and Countermeasure Plan is on file in Wiepking-Fullerton Energy, L.L.C. office.



Physical Address: 401 Arapahoe St.  
Mail to: Box 384 Kiowa, CO 80117  
Ph. 303-621-8672 - Fax 303-621-2717  
www.highprairiesurvey.com

Job: 10061 Bubba State #8


Inv # 1923

High Prairie Surveying of Kiowa, Colorado has in accordance with a request from **Jack Fincham, Wiepking Fullerton Energy** has determined the location of **Bubba-State #8** to be **1980 feet FSL**, and **660 feet FEL**, (90° off Section lines) of SECTION **20**, Township **10s**, Range **55w** of the 6th Principal Meridian, **Lincoln County**, Colorado.

Date: Staked on 5-04-12 drawn on 5-05-12.

Re: Staked by Keith Westfall  
Drawn: Drawn by Elijah Frane

## Topo Exhibit

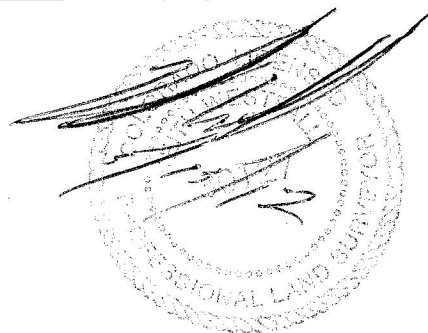

WIEPKING FULLERTON  
SE ¼ SEC 20-10S-55W  
BUBBA-STATE #8  
LINCOLN CO. COLORADO

