

General Comments

User Group Comment

Comment Date


Total:

P&A Completed
08-17-2012

Cut 4' of Surface pipe off below
Ground level for MARKER.

WELDION PLATE with LEGALS

SET a 100' CEMENT plug 4' Below
GROUND LEVEL TO Top of Fill DIRT.

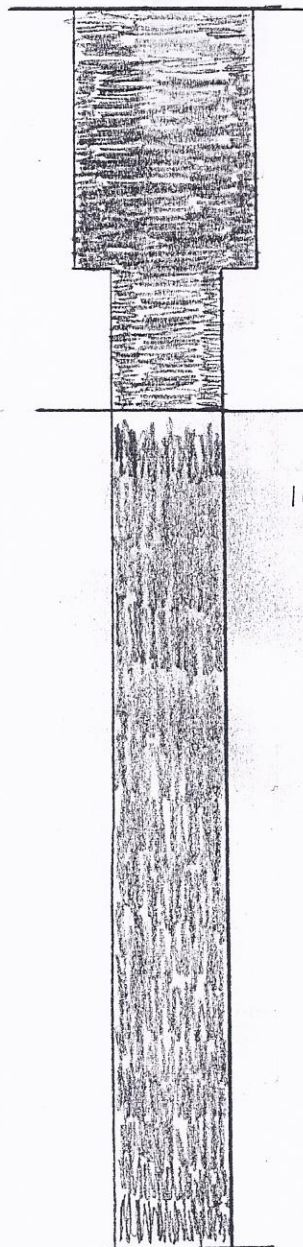

FILLED HOLE WITH DIRT 2970' TO
104' from Surface. measured &
TAGGED Fill Gauge TAPE.

Total Depth 2970'