



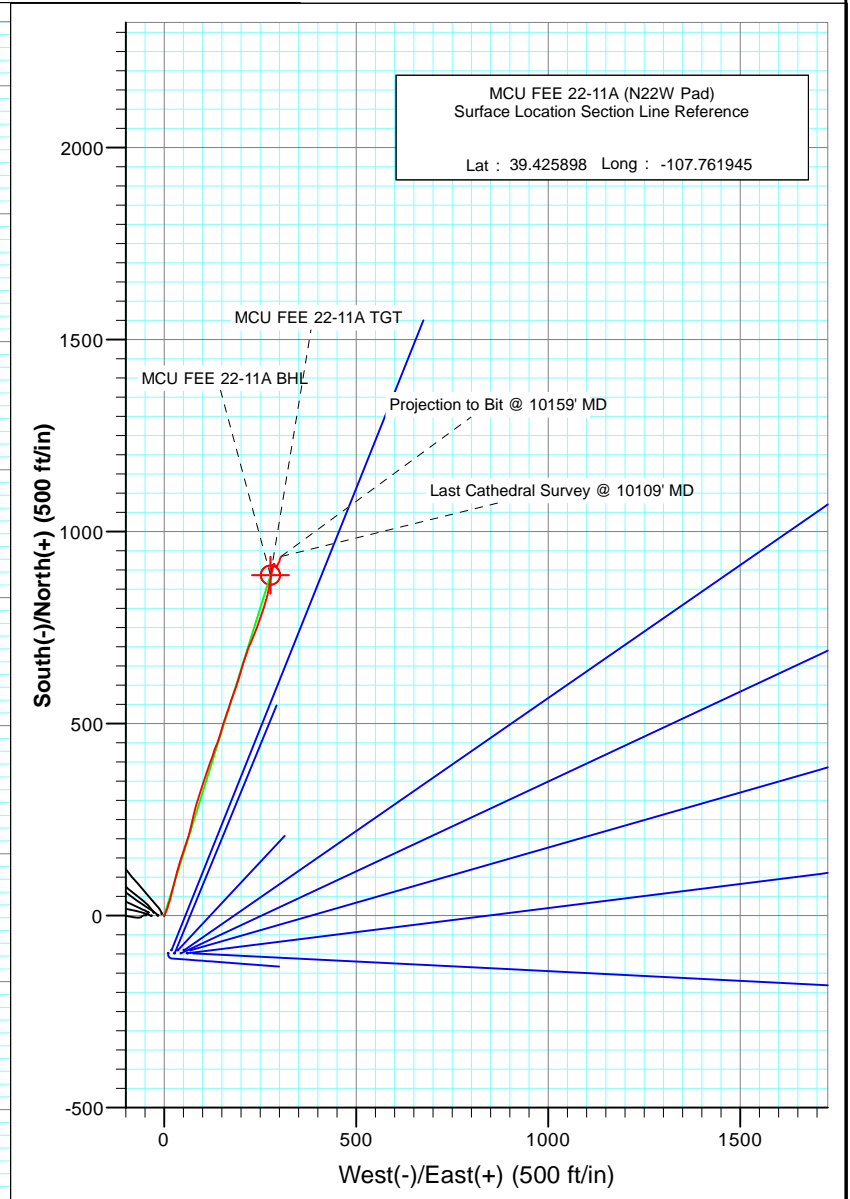

Project: Mamm Creek
Site: N22W Pad OH (MCU FEE 22-11A)
Well: MCU FEE 22-11A (N22W Pad)
Wellbore: OH
Plan: FINAL

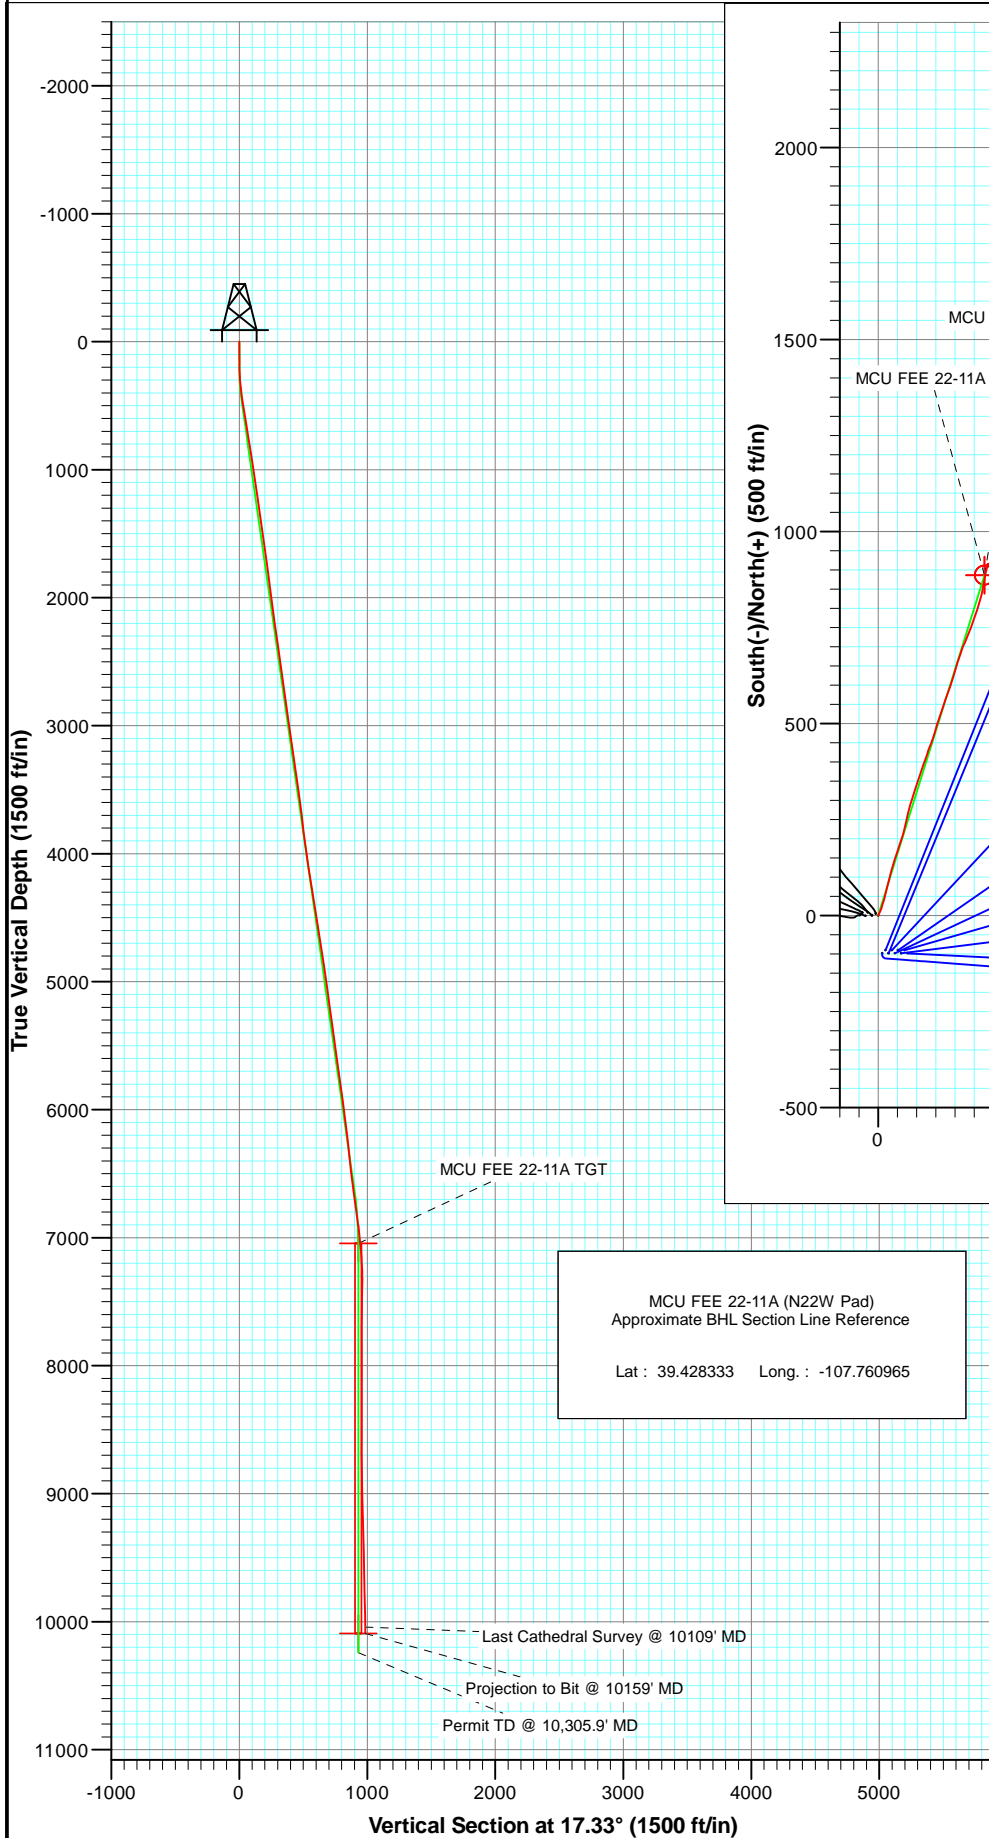


Azimuths to True North
Magnetic North: 10.12°

Magnetic Field
Strength: 52139.1snT
Dip Angle: 65.70°
Date: 5/23/2012
Model: IGRF2010



Project: Mamm Creek
Site: N22W Pad Final (MCU FEE 22-11A)
Well: MCU FEE 22-11A (N22W Pad)
Wellbore: OH
Plan: Final

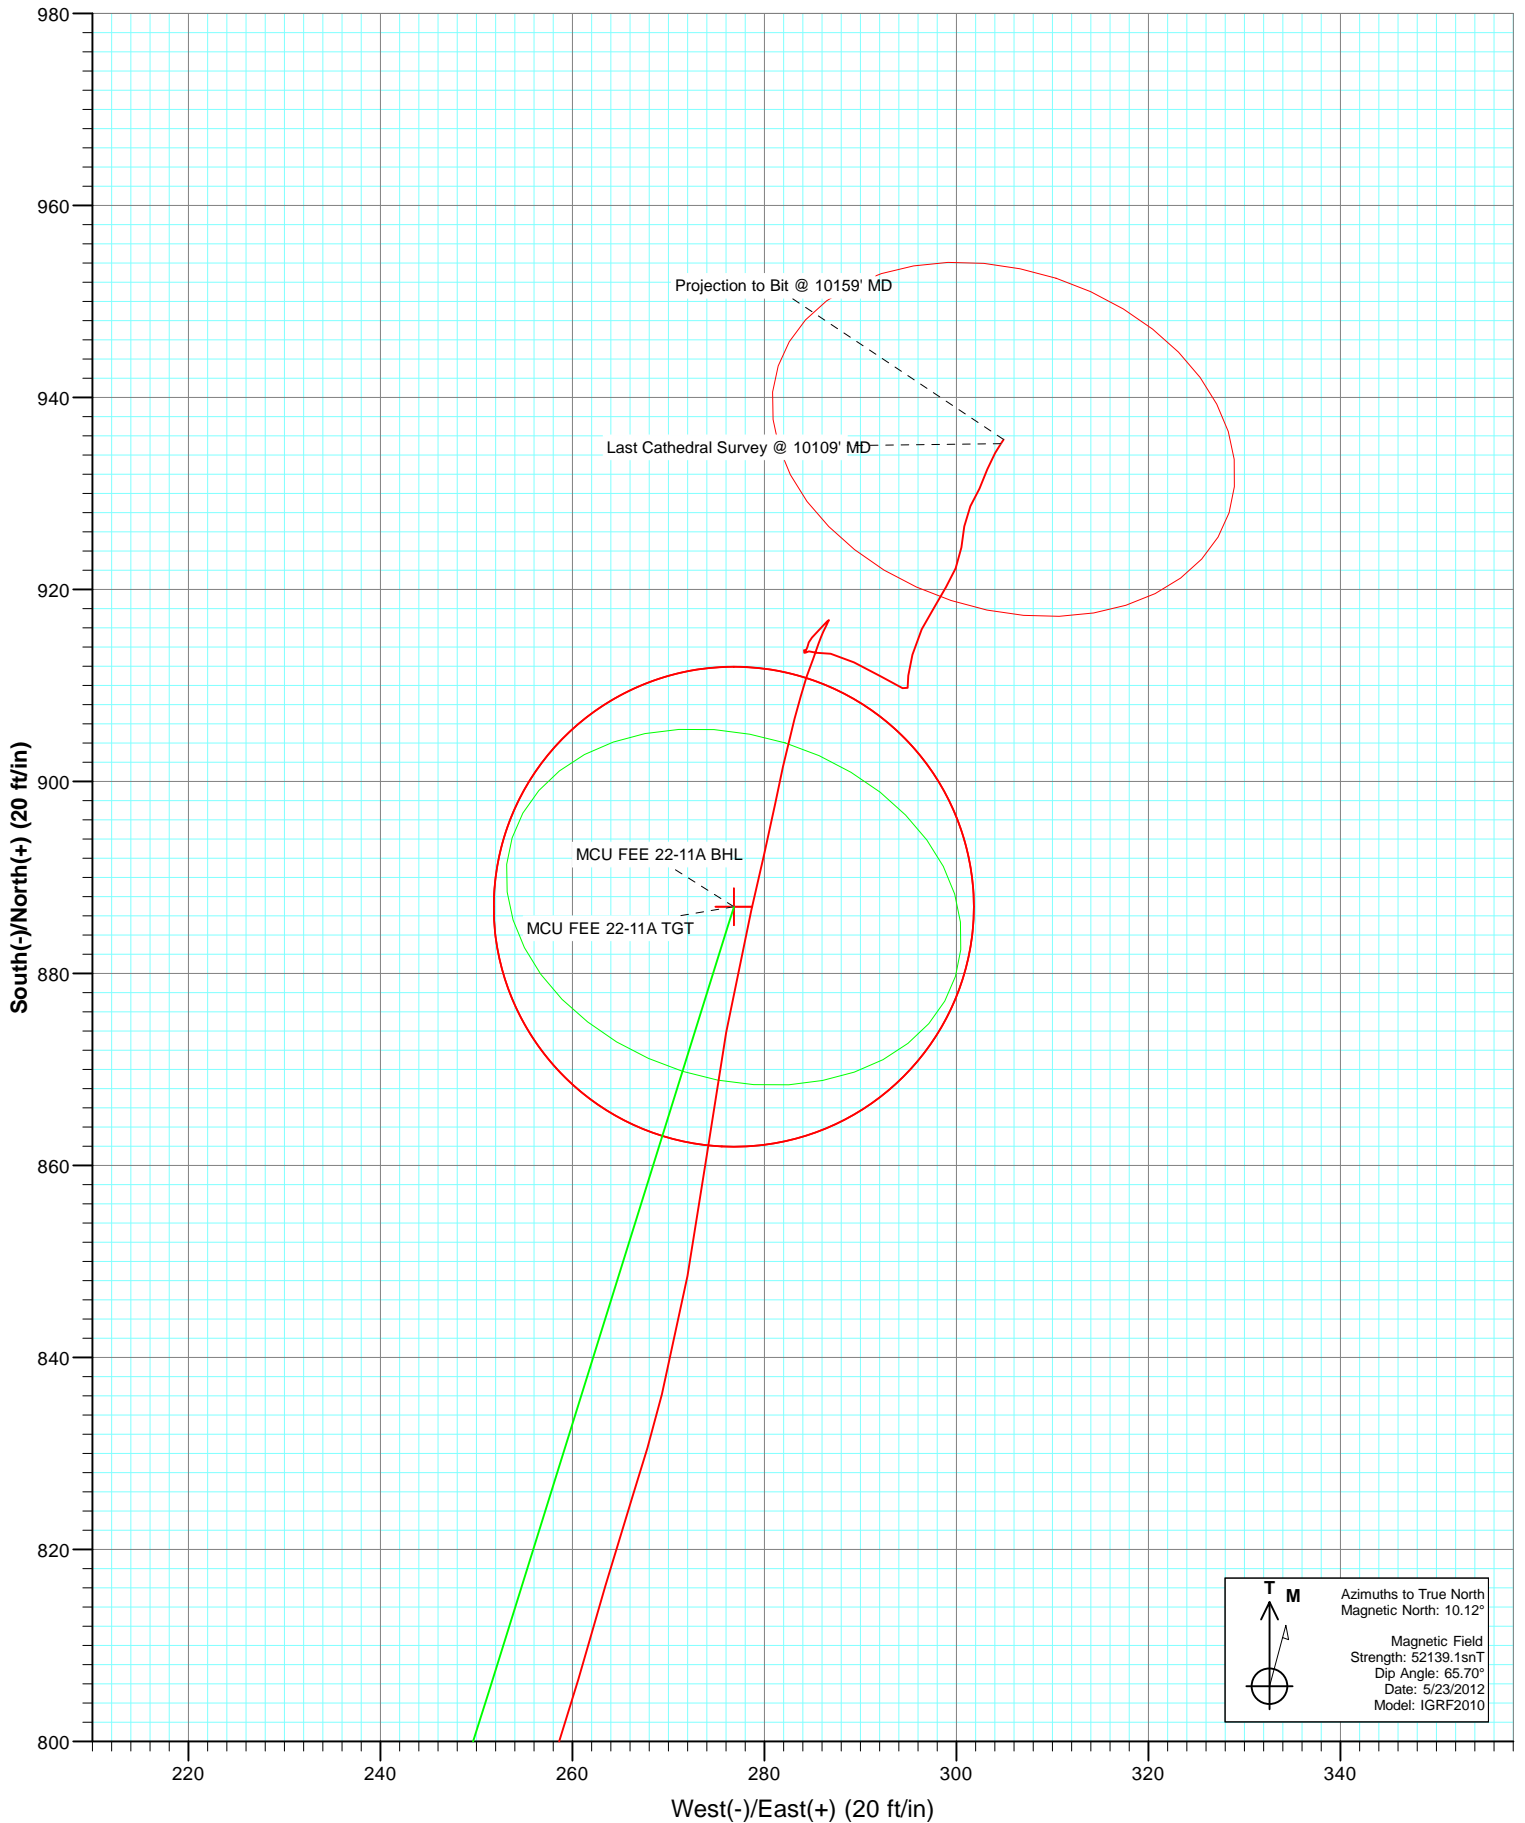

Cathedral Energy Services

Survey Report

Company:	EnCana Oil & Gas (USA) Inc	Local Co-ordinate Reference:	Well MCU FEE 22-11A (N22W Pad)
Project:	Mamm Creek	TVD Reference:	KBE @ 7048.0ft (Nabors M15)
Site:	N22W Pad	MD Reference:	KBE @ 7048.0ft (Nabors M15)
Well:	MCU FEE 22-11A (N22W Pad)	North Reference:	True
Wellbore:	OH	Survey Calculation Method:	Minimum Curvature
Design:	Final	Database:	USA EDM 5000 Multi Users DB

Project	Mamm Creek		
Map System:	US State Plane 1983	System Datum:	Mean Sea Level
Geo Datum:	North American Datum 1983		
Map Zone:	Colorado Central Zone		

Site		N22W Pad			
Site Position:		Northing:	1,587,870.64 ft	Latitude:	39.425629
From:	Lat/Long	Easting:	2,361,187.41 ft	Longitude:	-107.761673
Position Uncertainty:	0.0 ft	Slot Radius:	13.200 in	Grid Convergence:	-1.43 °

Well	MCU FEE 22-11A (N22W Pad)					
Well Position	+N/-S	0.0 ft	Northing:	1,587,970.46 ft	Latitude:	39.425898
	+E/-W	0.0 ft	Easting:	2,361,113.04 ft	Longitude:	-107.761945
Position Uncertainty		0.0 ft	Wellhead Elevation:	ft	Ground Level:	7,026.0 ft

Wellbore	OH				
Magnetics	Model Name	Sample Date	Declination (°)	Dip Angle (°)	Field Strength (nT)
	IGRF2010	5/23/2012	10.12	65.70	52,139

Design	Final				
Audit Notes:					
Version:	1.0	Phase:	ACTUAL	Tie On Depth:	0.0
Vertical Section:	Depth From (TVD)	+N/-S (ft)	+E/-W (ft)	Direction (°)	
	0.0	0.0	0.0	17.33	

Survey Program	Date	6/7/2012			
From (ft)	To (ft)	Survey (Wellbore)	Tool Name	Description	
154.0	10,159.0	Survey #1 (OH)	MWD	Geolink MWD	

Survey										
Measured Depth (ft)	Inclination (°)	Azimuth (°)	Vertical Depth (ft)	+N/-S (ft)	+E/-W (ft)	Vertical Section (ft)	Dogleg Rate (°/100ft)	Build Rate (°/100ft)	Formations / Comments	
0.0	0.00	0.00	0.0	0.0	0.0	0.0	0.00	0.00		
154.0	0.60	22.90	154.0	0.7	0.3	0.8	0.39	0.39		
185.0	0.60	34.40	185.0	1.0	0.5	1.1	0.39	0.00		
215.0	1.40	16.40	215.0	1.5	0.7	1.6	2.83	2.67		
246.0	2.20	32.10	246.0	2.4	1.1	2.6	3.01	2.58		
277.0	3.30	24.20	276.9	3.7	1.8	4.1	3.74	3.55		
307.0	4.10	27.60	306.9	5.4	2.6	6.0	2.76	2.67		
399.0	7.80	20.60	398.4	14.2	6.3	15.4	4.09	4.02		
491.0	9.30	19.00	489.3	27.1	11.0	29.1	1.65	1.63		
583.0	9.00	16.40	580.2	41.0	15.4	43.7	0.56	-0.33		
674.0	9.20	14.60	670.0	54.9	19.3	58.1	0.38	0.22		
767.0	9.30	11.50	761.8	69.4	22.6	73.0	0.55	0.11		
859.0	9.10	10.90	852.6	83.9	25.5	87.6	0.24	-0.22		

Cathedral Energy Services

Survey Report

Company:	EnCana Oil & Gas (USA) Inc	Local Co-ordinate Reference:	Well MCU FEE 22-11A (N22W Pad)
Project:	Mamm Creek	TVD Reference:	KBE @ 7048.0ft (Nabors M15)
Site:	N22W Pad	MD Reference:	KBE @ 7048.0ft (Nabors M15)
Well:	MCU FEE 22-11A (N22W Pad)	North Reference:	True
Wellbore:	OH	Survey Calculation Method:	Minimum Curvature
Design:	Final	Database:	USA EDM 5000 Multi Users DB

Survey

Measured Depth (ft)	Inclination (°)	Azimuth (°)	Vertical Depth (ft)	+N/-S (ft)	+E/-W (ft)	Vertical Section (ft)	Dogleg Rate (°/100ft)	Build Rate (°/100ft)	Formations / Comments
949.0	8.80	15.10	941.5	97.5	28.6	101.6	0.80	-0.33	
1,041.0	8.40	15.40	1,032.5	110.8	32.2	115.3	0.44	-0.43	
1,132.0	8.60	17.20	1,122.5	123.7	36.0	128.8	0.37	0.22	
1,223.0	8.30	18.90	1,212.5	136.4	40.2	142.2	0.43	-0.33	
1,316.0	7.90	17.50	1,304.6	148.8	44.3	155.3	0.48	-0.43	
1,411.0	7.90	17.00	1,398.7	161.3	48.1	168.3	0.07	0.00	
1,507.0	7.90	18.30	1,493.8	173.9	52.1	181.5	0.19	0.00	
1,530.0	8.10	18.60	1,516.6	176.9	53.1	184.7	0.89	0.87	
1,638.0	8.50	19.80	1,623.4	191.6	58.3	200.3	0.40	0.37	
1,734.0	8.20	18.40	1,718.4	204.8	62.8	214.2	0.38	-0.31	
1,829.0	6.80	11.20	1,812.6	216.7	66.1	226.6	1.77	-1.47	
1,925.0	7.30	14.00	1,907.9	228.2	68.6	238.3	0.63	0.52	
2,020.0	7.50	13.30	2,002.1	240.1	71.5	250.5	0.23	0.21	
2,115.0	7.60	10.30	2,096.2	252.3	74.1	263.0	0.43	0.11	
2,211.0	7.90	14.30	2,191.4	265.0	76.8	275.8	0.64	0.31	
2,306.0	8.10	19.10	2,285.5	277.6	80.6	289.1	0.73	0.21	
2,401.0	7.70	15.30	2,379.5	290.1	84.5	302.1	0.69	-0.42	
2,496.0	8.40	19.40	2,473.6	302.8	88.5	315.4	0.95	0.74	
2,592.0	8.50	13.40	2,568.6	316.3	92.5	329.5	0.92	0.10	
2,687.0	7.80	18.70	2,662.6	329.2	96.2	342.9	1.08	-0.74	
2,782.0	7.70	20.50	2,756.7	341.3	100.5	355.7	0.28	-0.11	
2,877.0	7.50	17.90	2,850.9	353.2	104.6	368.3	0.42	-0.21	
2,973.0	7.70	15.70	2,946.1	365.3	108.3	381.0	0.37	0.21	
3,068.0	8.40	21.00	3,040.1	377.9	112.5	394.3	1.07	0.74	
3,163.0	8.70	20.00	3,134.1	391.2	117.4	408.4	0.35	0.32	
3,258.0	8.70	19.90	3,228.0	404.7	122.3	422.7	0.02	0.00	
3,353.0	7.90	17.20	3,322.0	417.7	126.7	436.4	0.94	-0.84	
3,449.0	8.40	19.30	3,417.0	430.6	131.0	450.0	0.61	0.52	
3,544.0	7.80	22.80	3,511.1	443.1	135.8	463.4	0.82	-0.63	
3,640.0	6.90	18.80	3,606.3	454.5	140.1	475.6	1.08	-0.94	
3,735.0	7.10	18.30	3,700.6	465.5	143.8	487.2	0.22	0.21	
3,830.0	6.90	17.40	3,794.9	476.5	147.4	498.8	0.24	-0.21	
3,926.0	6.70	15.50	3,890.2	487.4	150.6	510.2	0.31	-0.21	
4,021.0	7.80	14.70	3,984.4	499.0	153.7	522.1	1.16	1.16	
4,117.0	9.00	20.70	4,079.4	512.3	158.0	536.1	1.55	1.25	
4,212.0	9.40	18.80	4,173.2	526.6	163.1	551.3	0.53	0.42	
4,308.0	9.20	19.10	4,267.9	541.3	168.2	566.8	0.21	-0.21	
4,404.0	8.30	15.20	4,362.8	555.2	172.5	581.4	1.12	-0.94	
4,499.0	9.10	21.60	4,456.7	568.8	177.1	595.8	1.32	0.84	
4,593.0	8.80	20.40	4,549.6	582.5	182.3	610.4	0.38	-0.32	
4,689.0	9.20	19.40	4,644.4	596.6	187.4	625.4	0.45	0.42	
4,784.0	9.00	18.70	4,738.2	610.8	192.3	640.4	0.24	-0.21	
4,880.0	8.40	12.80	4,833.1	624.8	196.3	654.9	1.12	-0.62	
4,975.0	8.70	16.20	4,927.0	638.4	199.8	669.0	0.62	0.32	
5,070.0	7.90	19.50	5,021.0	651.5	204.0	682.7	0.98	-0.84	
5,166.0	7.70	19.90	5,116.1	663.7	208.4	695.7	0.22	-0.21	
5,261.0	7.80	17.80	5,210.3	675.9	212.5	708.5	0.32	0.11	
5,357.0	7.30	15.50	5,305.4	687.9	216.2	721.1	0.61	-0.52	
5,453.0	8.40	24.40	5,400.5	700.2	220.7	734.2	1.70	1.15	
5,548.0	7.80	23.20	5,494.6	712.5	226.1	747.5	0.66	-0.63	
5,643.0	8.10	21.90	5,588.7	724.6	231.1	760.5	0.37	0.32	
5,738.0	7.80	21.00	5,682.8	736.8	235.9	773.7	0.34	-0.32	
5,833.0	8.00	23.50	5,776.9	748.9	240.9	786.7	0.42	0.21	

Cathedral Energy Services

Survey Report

Company:	EnCana Oil & Gas (USA) Inc	Local Co-ordinate Reference:	Well MCU FEE 22-11A (N22W Pad)
Project:	Mamm Creek	TVD Reference:	KBE @ 7048.0ft (Nabors M15)
Site:	N22W Pad	MD Reference:	KBE @ 7048.0ft (Nabors M15)
Well:	MCU FEE 22-11A (N22W Pad)	North Reference:	True
Wellbore:	OH	Survey Calculation Method:	Minimum Curvature
Design:	Final	Database:	USA EDM 5000 Multi Users DB

Survey

Measured Depth (ft)	Inclination (°)	Azimuth (°)	Vertical Depth (ft)	+N/-S (ft)	+E/-W (ft)	Vertical Section (ft)	Dogleg Rate (°/100ft)	Build Rate (°/100ft)	Formations / Comments
5,929.0	7.80	20.60	5,872.0	761.1	245.8	799.8	0.46	-0.21	
6,023.0	7.60	19.50	5,965.1	773.0	250.2	812.4	0.26	-0.21	
6,119.0	7.30	16.50	6,060.3	784.8	254.0	824.8	0.51	-0.31	
6,214.0	6.90	17.30	6,154.6	796.0	257.4	836.6	0.43	-0.42	
6,309.0	6.30	16.80	6,248.9	806.5	260.6	847.5	0.63	-0.63	
6,404.0	6.00	15.30	6,343.4	816.2	263.4	857.7	0.36	-0.32	
6,499.0	5.90	18.50	6,437.9	825.7	266.3	867.5	0.36	-0.11	
6,594.0	7.30	14.10	6,532.3	836.1	269.3	878.4	1.57	1.47	
6,689.0	8.00	10.40	6,626.4	848.5	272.0	891.0	0.90	0.74	
6,781.0	7.80	7.80	6,717.5	861.0	274.0	903.5	0.45	-0.22	
6,876.0	8.00	10.20	6,811.6	873.9	276.0	916.4	0.41	0.21	
6,971.0	7.70	13.10	6,905.7	886.6	278.6	929.3	0.52	-0.32	
7,067.0	5.80	11.90	7,001.1	897.6	281.1	940.6	1.98	-1.98	
7,107.0	5.80	12.40	7,040.9	901.5	282.0	944.6	0.13	0.00	
7,107.7	5.79	12.42	7,041.6	901.6	282.0	944.7	1.68	-1.64	MCU FEE 22-11A TGT
7,162.0	4.90	14.70	7,095.6	906.5	283.2	949.7	1.68	-1.64	
7,193.0	4.10	15.50	7,126.5	908.9	283.8	952.2	2.59	-2.58	
7,224.0	3.70	18.60	7,157.5	910.9	284.4	954.3	1.46	-1.29	
7,257.0	3.30	22.20	7,190.4	912.8	285.1	956.3	1.38	-1.21	
7,290.0	2.70	16.70	7,223.4	914.4	285.7	958.0	2.01	-1.82	
7,322.0	1.80	28.80	7,255.3	915.6	286.1	959.2	3.17	-2.81	
7,352.0	1.40	21.40	7,285.3	916.3	286.5	960.1	1.50	-1.33	
7,386.0	0.40	37.40	7,319.3	916.8	286.7	960.6	3.00	-2.94	
7,417.0	1.10	227.80	7,350.3	916.7	286.6	960.4	4.82	2.26	
7,448.0	1.40	221.80	7,381.3	916.2	286.1	959.8	1.05	0.97	
7,543.0	0.60	226.10	7,476.3	915.0	285.0	958.3	0.85	-0.84	
7,638.0	0.20	173.30	7,571.3	914.5	284.6	957.8	0.53	-0.42	
7,733.0	0.40	209.10	7,666.3	914.0	284.5	957.3	0.28	0.21	
7,828.0	0.10	156.30	7,761.3	913.7	284.4	956.9	0.37	-0.32	
7,923.0	0.10	285.40	7,856.3	913.6	284.3	956.8	0.19	0.00	
8,019.0	0.10	301.70	7,952.3	913.7	284.2	956.8	0.03	0.00	
8,114.0	0.40	163.10	8,047.3	913.4	284.2	956.6	0.50	0.32	
8,209.0	0.40	1.70	8,142.3	913.4	284.3	956.6	0.83	0.00	
8,305.0	0.50	120.00	8,238.3	913.5	284.7	956.9	0.81	0.10	
8,400.0	0.50	80.60	8,333.3	913.4	285.4	957.0	0.35	0.00	
8,495.0	1.30	98.30	8,428.3	913.3	286.9	957.3	0.88	0.84	
8,590.0	1.90	118.90	8,523.2	912.4	289.3	957.2	0.87	0.63	
8,685.0	2.00	115.90	8,618.2	910.9	292.2	956.6	0.15	0.11	
8,780.0	1.00	123.90	8,713.1	909.7	294.4	956.1	1.07	-1.05	
8,874.0	0.60	342.10	8,807.1	909.7	294.9	956.3	1.61	-0.43	
8,970.0	1.00	15.70	8,903.1	911.0	295.0	957.5	0.63	0.42	
9,065.0	1.70	8.70	8,998.1	913.2	295.4	959.8	0.76	0.74	
9,161.0	1.70	31.00	9,094.1	915.8	296.4	962.6	0.68	0.00	
9,256.0	1.50	28.40	9,189.0	918.1	297.7	965.1	0.22	-0.21	
9,352.0	1.40	32.10	9,285.0	920.2	298.9	967.5	0.14	-0.10	
9,446.0	1.30	22.10	9,379.0	922.2	299.9	969.7	0.27	-0.11	
9,542.0	1.40	9.50	9,474.9	924.4	300.5	971.9	0.33	0.10	
9,636.0	1.30	5.40	9,568.9	926.6	300.8	974.1	0.15	-0.11	
9,731.0	1.40	28.20	9,663.9	928.7	301.5	976.3	0.57	0.11	
9,826.0	1.10	24.50	9,758.9	930.5	302.4	978.4	0.33	-0.32	
9,922.0	1.50	21.10	9,854.8	932.5	303.2	980.5	0.42	0.42	
10,017.0	0.80	33.90	9,949.8	934.2	304.1	982.4	0.78	-0.74	
10,109.0	0.60	30.60	10,041.8	935.2	304.7	983.5	0.22	-0.22	Last Cathedral Survey @ 10109' MD

Cathedral Energy Services

Survey Report

Company:	EnCana Oil & Gas (USA) Inc	Local Co-ordinate Reference:	Well MCU FEE 22-11A (N22W Pad)
Project:	Mamm Creek	TVD Reference:	KBE @ 7048.0ft (Nabors M15)
Site:	N22W Pad	MD Reference:	KBE @ 7048.0ft (Nabors M15)
Well:	MCU FEE 22-11A (N22W Pad)	North Reference:	True
Wellbore:	OH	Survey Calculation Method:	Minimum Curvature
Design:	Final	Database:	USA EDM 5000 Multi Users DB

Survey									
Measured Depth (ft)	Inclination (°)	Azimuth (°)	Vertical Depth (ft)	+N/-S (ft)	+E/-W (ft)	Vertical Section (ft)	Dogleg Rate (°/100ft)	Build Rate (°/100ft)	Formations / Comments
10,157.6	0.60	30.60	10,090.4	935.6	304.9	984.0	0.00	0.00	MCU FEE 22-11A BHL
10,159.0	0.60	30.60	10,091.8	935.6	304.9	984.0	0.00	0.00	Projection to Bit @ 10159' MD

Targets									
Target Name	Dip Angle (°)	Dip Dir. (°)	TVD (ft)	+N/-S (ft)	+E/-W (ft)	Northing (ft)	Easting (ft)	Latitude	Longitude
MCU FEE 22-11A TGT	0.00	0.00	7,043.0	886.9	276.8	1,588,850.25	2,361,411.86	39.428333	-107.760965
- hit/miss target									
- Shape									
- actual wellpath misses target center by 15.6ft at 7107.6ft MD (7041.4 TVD, 901.6 N, 282.0 E)									
- Point									
MCU FEE 22-11A BHL	0.00	0.00	10,091.0	886.9	276.8	1,588,850.25	2,361,411.86	39.428333	-107.760965
- actual wellpath misses target center by 56.2ft at 10157.6ft MD (10090.4 TVD, 935.6 N, 304.9 E)									
- Circle (radius 25.0)									

Design Annotations					
Measured Depth (ft)	Vertical Depth (ft)	Local Coordinates			
		+N/-S (ft)	+E/-W (ft)	Comment	
10,109.0	10,041.8	935.2	304.7	Last Cathedral Survey @ 10109' MD	
10,159.0	10,091.8	935.6	304.9	Projection to Bit @ 10159' MD	

Checked By: _____ Approved By: _____ Date: _____