



Physical Address: 401 Arapahoe St.
Mail to: Box 384 Kiowa, CO 80117
Ph. 303-621-8672 - Fax 303-621-2717
www.highprairiesurvey.com

Job: 10061 Kerry #8

Inv # 1921


High Prairie Surveying of Kiowa, Colorado has in accordance with a request from **Jack Fincham, Wiepking Fullerton Energy** has determined the location of **Kerry #8** to be **660 feet FNL**, and **660 feet FEL**, (90° off Section lines) of SECTION **20**, Township **10s**, Range **55w** of the 6th Principal Meridian, **Lincoln County**, Colorado.

Date: Staked on 5-04-12 drawn on 5-05-12.

Re: Staked by Keith Westfall

Drawn: Drawn by Elijah France

Reference Area

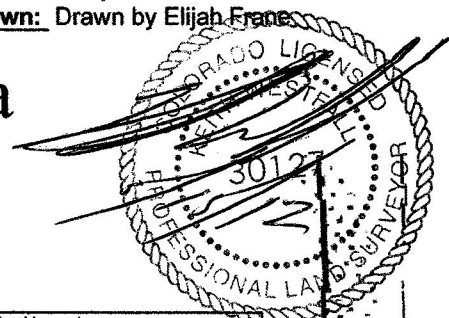

Wiepking Fullerton
NE ¼ Sec. 20-10s-55w
Kerry #8
Lincoln, Co. Colorado

Reference Area
Lat= 39.16455 (Dec. Degree)
Long=103.57266 (Dec. Degree)



20

5221