


Well Name: HICKS 07-11J7

VERTICAL - ORIGINAL HOLE, 12/31/2012 11:48:29 AM

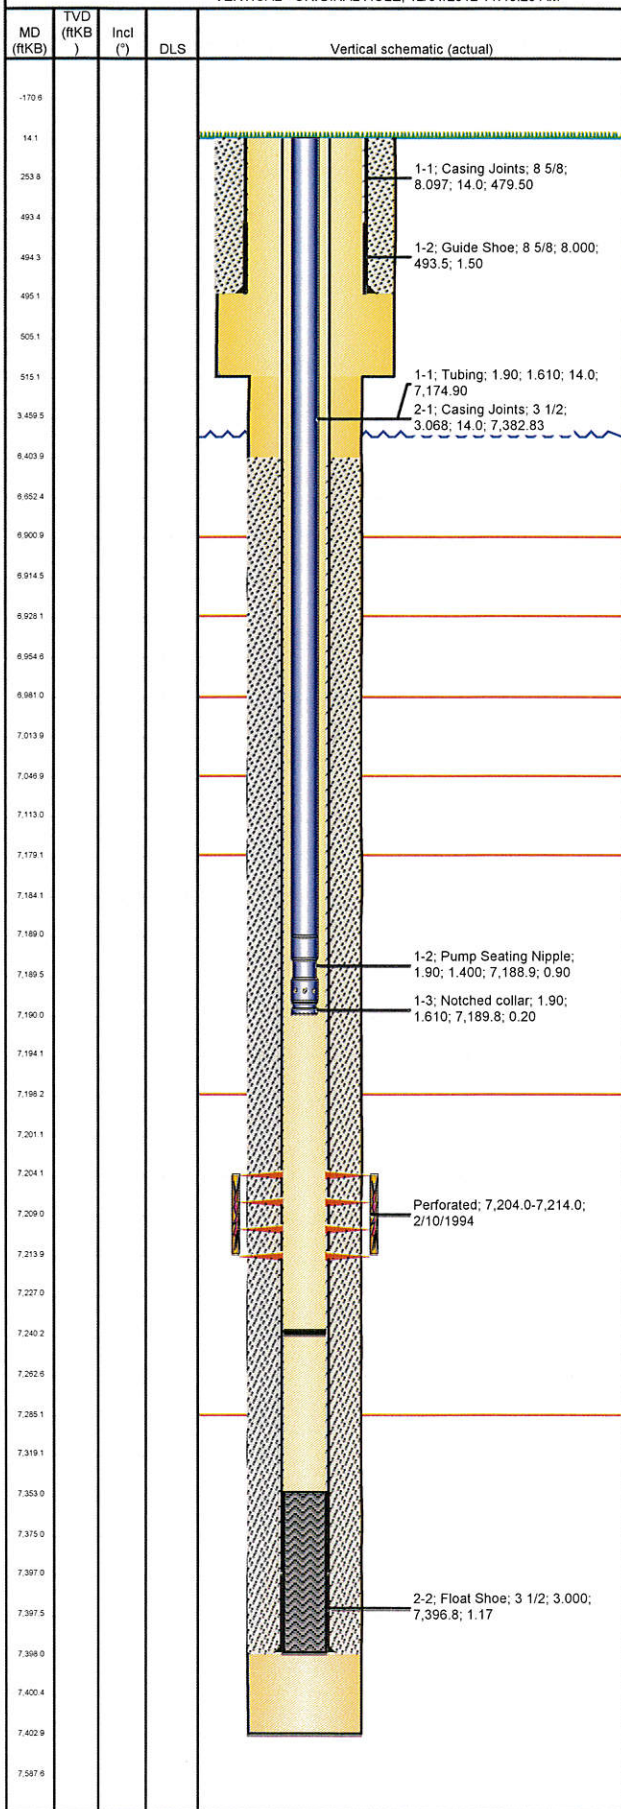

Well Header

API	Business Unit	District	Well Config
05-123-17709	WATTENBERG	15	VERTICAL
Original KB Elevation (ft)	KB - GL / MSL (ftKB)	Spud Date	P & A Date
4,884.00	14.00	1/23/1994	

Comment

FRAC'D INTO BY HS 11/2001; WELL - SI PER FOREMAN 12/2011.

Directions To Well

WCR 34 & WCR 13, E .4, N .3 INTO

Congressional Location

Quarter 1	Quarter 2	Quarter 3	Quarter 4	Section	Township	Twnshp N...	Range	Rng E/W Dir
		NE	SW	7		3 N	67	W

Bottom Hole Location

North-South Distance (ft)	From N or S Line	East-West Distance (ft)	From E or W Line

Plug Back Total Depths

Date	Depth (ftKB)	Method	Com
2/7/1994	7,353.0	CASING TALLY	
9/12/2006	7,240.0	TBG	NO TAG; C/O & SET TBG

Wellbore Sections

Section Des	Size (in)	Act Top (ftKB)	Act Btm (ftKB)
SURFACE	12 1/4	14.0	515.0
PRODUCTION	7 7/8	515.0	7,403.0

Zone Statuses

Zone Name	Status Date	Status	Job
CODELL	2/19/1994	PR	DRILLING/COMPLETION - ORIGINAL, 1/23/1994 00:00
CODELL	9/15/2006	PR	TUBING REPAIR, 8/28/2006 00:00

Casing Strings

Surface, 495.0ftKB

Casing Description	Run Date	OD (in)	Wt/Len (l...)	Grade	Top (ftKB)	Set Depth...
Surface	1/27/1994	8 5/8	23.00	M-50	14.0	495.0

Production, 7,398.0ftKB

Casing Description	Run Date	OD (in)	Wt/Len (l...)	Grade	Top (ftKB)	Set Depth...
Production	2/7/1994	3 1/2	7.70	M-75	14.0	7,398.0

Cement

Description	Top Depth (ftKB)	Bottom Depth (ftKB)
SURFACE CASING CEMENT	14.0	495.0
Description	Top Depth (ftKB)	Bottom Depth (ftKB)
PRODUCTION CASING CEMENT	6,404.0	7,398.0

Tubing Components

Item Des	OD (in)	Wt (lb/ft)	Grade	Jts	Len (ft)	Btm (ftKB)	Btm (TVD) (ftKB)
Tubing	1.9	2.75	J-55	211	7,174.90	7,188.9	
Pump Seating Nipple	1.9			1	0.90	7,189.8	
Notched collar	1.9			1	0.20	7,190.0	

Perforation Data

Zone	Bnch/St g	Entered Shot Total	Top (ftKB)	Btm (ftKB)	Date
CODELL, ORIGINAL HOLE		20	7,204.00	7,214.00	2/10/1994

Stimulations & Treatments

Date	Zone	Primary Job Type
2/14/1994	CODELL, ORIGINAL HOLE	DRILLING/COMPLETION - ORIGINAL
Technical Result	Tech Result Details	Tech Result Note

Comment

Other In Hole

Run Date	Des	OD (in)	Top (ftKB)	Btm (ftKB)

Logs

Date	Type	Top (ftKB)	Btm (ftKB)
1/29/1994	COMPENSATED DENSITY	3,950.0	7,454.0
1/29/1994	INDUCTION	508.0	7,393.0
2/10/1994	PFC	6,680.0	7,325.0