


Lease Review All												
Well Name: WOLF 35-2613H												
API Number		WPC ID		Well Permit Number		Field Name		County		State		
051233549900		1CO076848		400266849		Wildcat		Weld		CO		
Well Configuration Type		Orig KB Elv (ft)		Ground Elevation (ft)		Casing Flange Elevation (ft)		Tubing Head Elevation (ft)		Total Depth (ftKB)		
Lateral/Horizontal		5,015.00		4,998.50						12,655.0		
Original Spud Date		Completion Date		Asset Group		Responsible Engineer		N/S Dist (ft)		E/W Dist (ft)		
6/29/2012		8/25/2012		Central Rockies Asset Group		Gary Nordlander		330.0		660.0		
N/S Ref		E/W Ref										
FSL		FWL										
Lot		Quarter 1		Quarter 2		Quarter 3		Quarter 4		Section		
		SW		SW						35		
Section Suffix		Section Type		Township		Township N/S Dir		Range		Range E/W Dir		
				10		N		59		W		
Meridian												
6TH												
Lateral/Horizontal - Original Hole, 10/4/2012 12:53:47 PM												
Wellbore Sections												
Wellbore Name												
Start Date												
Size (in)												
Act Top (ftKB)												
Act Btm (ftKB)												
Original Hole												
6/29/2012												
13 1/2												
16.5												
1,530.0												
Original Hole												
7/1/2012												
8 3/4												
1,530.0												
6,659.0												
Original Hole												
7/8/2012												
6												
6,659.0												
12,655.0												
Surface Csg, 1,519.7ftKB												
OD (in)												
Wt (lb/ft)												
Grade												
Top (ftKB)												
Btm (ftKB)												
Len (ft)												
Item Des												
9 5/8												
36.00												
J-55												
16.5												
1,475.1												
1,458.59												
Casing Joints												
9 5/8												
1,475.1												
1,476.6												
1.50												
float collar												
9 5/8												
36.00												
J-55												
1,476.6												
1,518.2												
41.61												
Casing Joints												
9 5/8												
1,518.2												
1,519.7												
1.50												
Guide Shoe												
Intermediate Csg, 6,640.4ftKB												
OD (in)												
Wt (lb/ft)												
Grade												
Top (ftKB)												
Btm (ftKB)												
Len (ft)												
Item Des												
16.5												
16.5												
0.00												
Casing Joints												
7												
29.00												
HCL-80												
16.5												
16.5												
0.00												
Landing Joint												
7												
29.00												
HCL-80												
16.5												
18.5												
2.00												
Casing Hanger												
7												
29.00												
HCL-80												
18.5												
23.5												
5.00												
PUP Joint												
7												
29.00												
HCL-80												
23.5												
6,592.1												
6,592.1												
6,568.57												
Casing Joints												
7												
29.00												
HCL-80												
6,592.1												
6,593.6												
1.50												
Float Collar												
7												
29.00												
HCL-80												
6,593.6												
6,638.9												
45.28												
Casing Joints												
7												
29.00												
HCL-80												
6,638.9												
6,640.4												
1.50												
Guide Shoe												
Liner, 12,650.0ftKB												
OD (in)												
Wt (lb/ft)												
Grade												
Top (ftKB)												
Btm (ftKB)												
Len (ft)												
Item Des												
4 1/2												
11.60												
SeAH-90												
5,247.3												
5,247.3												
0.00												
Casing Joints												
6.184												
11.60												
P-110												
5,247.3												
5,268.6												
21.30												
Zx-p Liner TP												
6.184												
11.60												
P-110												
5,268.6												
5,278.4												
9.80												
Liner Hanger												
4 1/2												
11.60												
P-110												
5,278.4												
5,283.9												
5.51												
PUP Joint												
4 1/2												
11.60												
SeAH-90												
5,283.9												
6,638.1												
1,354.25												
Casing Joints												
4 1/2												
11.60												
P-110												
6,638.1												
6,650.2												
12.11												
Swell Packer												
4 1/2												
11.60												
SeAH-90												
6,650.2												
6,740.5												
90.30												
Casing Joints												
4 1/2												
11.60												
P-110												
6,740.5												
6,752.6												
12.10												
Frac Sleeve												
4 1/2												
11.60												
SeAH-90												
6,752.6												
6,842.9												
90.27												
Casing Joints												
4 1/2												
11.60												
P-110												
6,842.9												
6,855.0												
12.11												
Swell Packer												
4 1/2												
11.60												
SeAH-90												
6,855.0												
6,945.3												
90.28												
Casing Joints												
4 1/2												
11.60												
P-110												
6,945.3												
6,957.4												
12.08												
Frac Sleeve												
4 1/2												
11.60												
SeAH-90												
6,957.4												
7,047.6												
90.25												
Casing Joints												
4 1/2												
11.60												
P-110												
7,047.6												
7,059.7												
12.11												
Swell Packer												
4 1/2												
11.60												
SeAH-90												
7,059.7												
7,150.0												
90.29												
Casing Joints												
4 1/2												
11.60												
P-110												
7,150.0												
7,162.1												
12.09												
Frac Sleeve												
4 1/2												
11.60												
SeAH-90												
7,162.1												
7,252.4												
90.25												
Casing Joints												
4 1/2												
11.60												
P-110												
7,252.4												
7,264.5												
12.10												
Swell Packer												
4 1/2												
11.60												
SeAH-90												
7,264.5												
7,354.8												
90.31												
Casing Joints												
4 1/2												
11.60												
P-110												
7,354.8												
7,366.9												
12.11												
Frac Sleeve												
4 1/2												
11.60												
SeAH-90												
7,366.9												
7,457.1												
90.27												
Casing Joints												
4 1/2												
11.60												
P-110												
7,457.1												
7,469.3												
12.12												
Swell Packer												
4 1/2												
11.60												
SeAH-90												
7,469.3												
7,559.5												
90.26												
Casing Joints												
4 1/2												
11.60												
P-110												
7,559.5												
7,571.6												
12.07												
Frac Sleeve												
4 1/2												
11.60												
SeAH-90												
7,571.6												
7,661.9												
90.33												
Casing Joints												
4 1/2												
11.60												
P-110												
7,661.9												
7,674.0												
12.10												
Swell Packer												
4 1/2												
11.60												
SeAH-90												
7,674.0												
7,764.4												
90.33												
Casing Joints												
4 1/2												
11.60												
P-110												
7,764.4												
7,776.5												
12.12												
Frac Sleeve												
4 1/2												
11.60												
SeAH-90												
7,776.5												
7,866.8												
90.31												
Casing Joints												
4 1/2												
11.60												
P-110												
7,866.8												
7,878.9												
12.11												
Swell Packer												
4 1/2												
11.60												
SeAH-90												
7,878.9												
7,969.2												
90.32												
Casing Joints												
4 1/2												
11.60												
P-110												
7,969.2												
7,981.3												
12.10												
Frac Sleeve												
4 1/2												
11.60												
SeAH-90												
7,981.3												
8,071.6												
90.30												
Casing Joints												
4 1/2												
11.60												
P-110												
8,071.6												
8,083.7												
12.10												
Swell Packer												
4 1/2												
11.60												
SeAH-90												
8,083.7												
8,174.0												
90.25												
Casing Joints												
4 1/2												
11.60												
P-110												
8,174.0												
8,186.1												
12.11												
Frac Sleeve												
4 1/2												
11.60												
SeAH-90												
8,186.1												
8,276.3												
90.22												
Casing Joints												
4 1/2												
11.60												
P-110												
8,276.3												
8,288.4												
12.11												
Swell Packer												
4 1/2												
11.60												
SeAH-90												
8,288.4												
8,378.7												
90.25												
Casing Joints												
4 1/2												
11.60												
P-110												
8,378.7												
8,390.7												
12.05												
Frac Sleeve												
4 1/2												
11.60												
SeAH-90												
8,390.7												
8,481.0												
90.28												
Casing Joints												
4 1/2												
11.60												
P-110												
8,481.0												
8,493.1												
12.10												
Swell Packer												
4 1/2												
11.60												
SeAH-90												
8,493.1												
8,583.3												
90.26												
Casing Joints												
4 1/2												
11.60												
P-110												
8,583.3												
8,595.4												
12.09												
Frac Sleeve												
4 1/2												
11.60												
SeAH-90												
8,595.4												
8,685.7												
90.31												
Casing Joints												
4 1/2												
11.60												
P-110												
8,685.7												
8,697.9												
12.11												
Swell Packer												
4 1/2												
11.60												
SeAH-90												
8,697.9												
8,788.1												
90.21												
Casing Joints												
4 1/2												
11.60												
P-110												
8,788.1												
8,800.2												
12.11												
Frac Sleeve												
4 1/2												
11.60												
SeAH-90												
8,800.2												
8,890.4												
90.24												
Casing Joints												
4 1/2												
11.60												
P-110												
8,890.4												
8,902.4												
12.01												
Swell Packer												

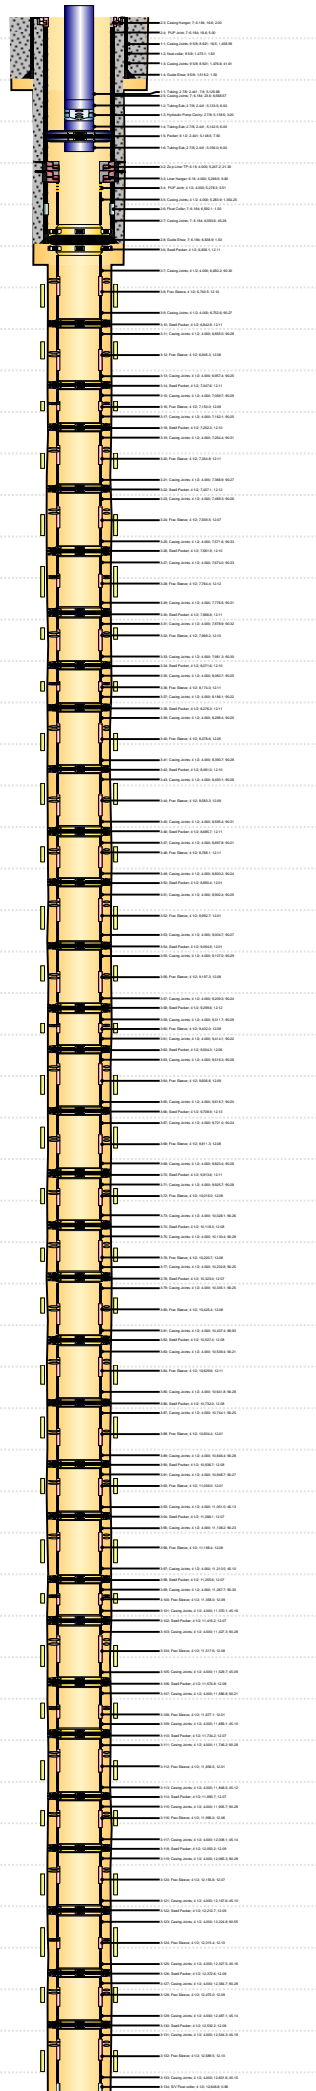

Lease Review All
Well Name: WOLF 35-2613H

API Number 051233549900				WPC ID 1CO076848				Well Permit Number 400266849				Field Name Wildcat				County Weld		State CO																			
Well Configuration Type Lateral/Horizontal								Orig KB Elv (ft) 5,015.00				Ground Elevation (ft) 4,998.50				Casing Flange Elevation (ft)				Tubing Head Elevation (ft)				Total Depth (ftKB) 12,655.0													
Original Spud Date 6/29/2012				Completion Date 8/25/2012				Asset Group Central Rockies Asset Group				Responsible Engineer Gary Nordlander				N/S Dist (ft) 330.0				N/S Ref FSL		E/W Dist (ft) 660.0				E/W Ref FWL											
Lot		Quarter 1 SW		Quarter 2 SW		Quarter 3		Quarter 4		Section 35		Section Suffix		Section Type		Township 10 N		Township N/S Dir		Range 59 W		Range E/W Dir		Meridian 6TH													
Lateral/Horizontal - Original Hole, 10/4/2012 12:53:50 PM																								OD (in)		W/t (lb/ft)		Grade		Top (ftKB)		Btm (ftKB)		Len (ft)		Item Des	
MD (ftKB)	TV D (ftK B)	In cl (°)									4 1/2		11.60		SeAH-90		8,902.4		8,992.7		90.25		Casing Joints														
											4 1/2		11.60		P-110		8,992.7		9,004.7		12.01		Frac Sleeve														
											4 1/2		11.60		SeAH-90		9,004.7		9,095.0		90.27		Casing Joints														
											4 1/2		11.60		P-110		9,095.0		9,107.0		12.01		Swell Packer														
											4 1/2		11.60		SeAH-90		9,107.0		9,197.3		90.29		Casing Joints														
											4 1/2		11.60		P-110		9,197.3		9,209.3		12.08		Frac Sleeve														
											4 1/2		11.60		SeAH-90		9,209.3		9,299.6		90.24		Casing Joints														
											4 1/2		11.60		P-110		9,299.6		9,311.7		12.12		Swell Packer														
											4 1/2		11.60		SeAH-90		9,311.7		9,402.0		90.29		Casing Joints														
											4 1/2		11.60		P-110		9,402.0		9,414.1		12.09		Frac Sleeve														
											4 1/2		11.60		SeAH-90		9,414.1		9,504.3		90.22		Casing Joints														
											4 1/2		11.60		P-110		9,504.3		9,516.4		12.06		Swell Packer														
											4 1/2		11.60		SeAH-90		9,516.4		9,606.6		90.26		Casing Joints														
											4 1/2		11.60		P-110		9,606.6		9,618.7		12.09		Frac Sleeve														
											4 1/2		11.60		SeAH-90		9,618.7		9,708.9		90.20		Casing Joints														
											4 1/2		11.60		P-110		9,708.9		9,721.0		12.13		Swell Packer														
											4 1/2		11.60		SeAH-90		9,721.0		9,811.3		90.24		Casing Joints														
											4 1/2		11.60		P-110		9,811.3		9,823.4		12.08		Frac Sleeve														
											4 1/2		11.60		SeAH-90		9,823.4		9,913.6		90.26		Casing Joints														
											4 1/2		11.60		P-110		9,913.6		9,925.7		12.11		Swell Packer														
											4 1/2		11.60		SeAH-90		9,925.7		10,016.0		90.28		Casing Joints														
											4 1/2		11.60		P-110		10,016.0		10,028.1		12.08		Frac Sleeve														
											4 1/2		11.60		SeAH-90		10,028.1		10,118.3		90.26		Casing Joints														
											4 1/2		11.60		P-110		10,118.3		10,130.4		12.08		Swell Packer														
											4 1/2		11.60		SeAH-90		10,130.4		10,220.7		90.28		Casing Joints														
											4 1/2		11.60		P-110		10,220.7		10,232.8		12.08		Frac Sleeve														
											4 1/2		11.60		SeAH-90		10,232.8		10,323.0		90.25		Casing Joints														
											4 1/2		11.60		P-110		10,323.0		10,335.1		12.07		Swell Packer														
											4 1/2		11.60		SeAH-90		10,335.1		10,425.4		90.25		Casing Joints														
											4 1/2		11.60		P-110		10,425.4		10,437.4		12.08		Frac Sleeve														
											4 1/2		11.60		SeAH-90		10,437.4		10,527.4		89.93		Casing Joints														
											4 1/2		11.60		P-110		10,527.4		10,539.4		12.08		Swell Packer														
4 1/2		11.60		SeAH-90		10,539.4		10,629.7		90.21		Casing Joints																									
4 1/2		11.60		P-110		10,629.7		10,641.8		12.11		Frac Sleeve																									
4 1/2		11.60		SeAH-90		10,641.8		10,732.0		90.28		Casing Joints																									
4 1/2		11.60		P-110		10,732.0		10,744.1		12.08		Swell Packer																									
4 1/2		11.60		SeAH-90		10,744.1		10,834.4		90.25		Casing Joints																									
4 1/2		11.60		P-110		10,834.4		10,846.4		12.01		Frac Sleeve																									
4 1/2		11.60		SeAH-90		10,846.4		10,936.7		90.28		Casing Joints																									
4 1/2		11.60		P-110		10,936.7		10,948.7		12.08		Swell Packer																									
4 1/2		11.60		SeAH-90		10,948.7		11,039.0		90.27		Casing Joints																									
4 1/2		11.60		P-110		11,039.0		11,051.0		12.01		Frac Sleeve																									
4 1/2		11.60		SeAH-90		11,051.0		11,096.2		45.13		Casing Joints																									
4 1/2		11.60		P-110		11,096.2		11,108.2		12.07		Swell Packer																									
4 1/2		11.60		SeAH-90		11,108.2		11,198.5		90.23		Casing Joints																									
4 1/2		11.60		P-110		11,198.5		11,210.5		12.08		Frac Sleeve																									
4 1/2		11.60		SeAH-90		11,210.5		11,255.6		45.10		Casing Joints																									
4 1/2		11.60		P-110		11,255.6		11,267.7		12.07		Swell Packer																									
4 1/2		11.60		SeAH-90		11,267.7		11,358.0		90.30		Casing Joints																									
4 1/2		11.60		P-110		11,358.0		11,370.1		12.09		Frac Sleeve																									
4 1/2		11.60		SeAH-90		11,370.1		11,415.3		45.16		Casing Joints																									
4 1/2		11.60		P-110		11,415.3		11,427.3		12.07		Swell Packer																									
4 1/2		11.60		SeAH-90		11,427.3		11,517.6		90.28		Casing Joints																									
4 1/2		11.60		P-110		11,517.6		11,529.7		12.08		Frac Sleeve																									
4 1/2		11.60		SeAH-90		11,529.7		11,574.8		45.09		Casing Joints																									
4 1/2		11.60		P-110		11,574.8		11,586.9		12.08		Swell Packer																									
4 1/2		11.60		SeAH-90		11,586.9		11,677.1		90.21		Casing Joints																									
4 1/2		11.60		P-110		11,677.1		11,689.1		12.01		Frac Sleeve																									
4 1/2		11.60		SeAH-90		11,689.1		11,734.2		45.10		Casing Joints																									
4 1/2		11.60		P-110		11,734.2		11,746.2		12.07		Swell Packer																									
4 1/2		11.60		SeAH-90		11,746.2		11,836.5		90.29		Casing Joints																									
4 1/2		11.60		P-110		11,836.5		11,848.5		12.01		Frac Sleeve																									
4 1/2		11.60		SeAH-90		11,848.5		11,893.7		45.12		Casing Joints																									
4 1/2		11.60		P-110		11,893.7		11,905.7		12.07		Swell Packer																									
4 1/2		11.60		SeAH-90		11,905.7		11,996.0		90.28		Casing Joints																									
4 1/2		11.60		P-110		11,996.0		12,008.1		12.06		Frac Sleeve																									
4 1/2		11.60		SeAH-90		12,008.1		12,053.2		45.14		Casing Joints																									
4 1/2		11.60		P-110		12,053.2		12,065.3		12.09		Swell Packer																									
4 1/2		11.60		SeAH-90		12,065.3		12,155.6		90.28		Casing Joints																									
4 1/2		11.60		P-110		12,155.6		12,167.7		12.07		Frac Sleeve																									
4 1/2		11.60		SeAH-90		12,167.7		12,212.8		45.10		Casing Joints																									

Lease Review All															
Well Name: WOLF 35-2613H															
API Number 051233549900			WPC ID 1CO076848			Well Permit Number 400266849			Field Name Wildcat			County Weld		State CO	
Well Configuration Type Lateral/Horizontal			Orig KB Elv (ft) 5,015.00			Ground Elevation (ft) 4,998.50			Casing Flange Elevation (ft)		Tubing Head Elevation (ft)		Total Depth (ftKB) 12,655.0		
Original Spud Date 6/29/2012		Completion Date 8/25/2012		Asset Group Central Rockies Asset Group			Responsible Engineer Gary Nordlander			N/S Dist (ft) 330.0		N/S Ref FSL	E/W Dist (ft) 660.0		E/W Ref FWL
Lot		Quarter 1 SW	Quarter 2 SW	Quarter 3	Quarter 4	Section 35	Section Suffix	Section Type		Township 10 N	Township N/S Dir		Range 59	Range E/W Dir W	Meridian 6TH
Lateral/Horizontal - Original Hole, 10/4/2012 12:53:52 PM															



Lease Review All
Well Name: WOLF 35-2613H

API Number 051233549900			WPC ID 1CO076848			Well Permit Number 400266849			Field Name Wildcat			County Weld			State CO		
Well Configuration Type Lateral/Horizontal					Orig KB Elv (ft) 5,015.00		Ground Elevation (ft) 4,998.50		Casing Flange Elevation (ft)		Tubing Head Elevation (ft)			Total Depth (ftKB) 12,655.0			
Original Spud Date 6/29/2012			Completion Date 8/25/2012		Asset Group Central Rockies Asset Group			Responsible Engineer Gary Nordlander			N/S Dist (ft) 330.0		N/S Ref FSL		E/W Dist (ft) 660.0		E/W Ref FWL
Lot		Quarter 1 SW	Quarter 2 SW	Quarter 3	Quarter 4	Section 35	Section Suffix	Section Type		Township 10 N	Township N/S Dir	Range 59 W	Range E/W Dir		Meridian 6TH		

Lateral/Horizontal - Original Hole, 10/4/2012 12:53:55 PM					Stim/Treat Stages						
MD (ftKB)	TV D (ftKB)	In cl (°)	Vertical schematic (actual)	Logs	Stage Type	Start Date	Top (ftKB)	Btm (ftKB)	Stim/Treat Fluid	Vol Clean Pump (bbl)	
23.6	6,238.2	90.6			Frac	8/20/2012	10,221.0	10,233.0	21807# 40/70,88477# 20/40 Ottw sd,22572# 20/40 CRC, Slick Water	2807.00	
1,519.7	6,222.5	90.6		Frac	8/20/2012	10,425.0	10,437.0	18135# 40/70,90548# 20/40 Ottw sd,23306# 20/40 CRC, Slick Water	2829.00		
5,142.4	6,184.6	90.6		Frac	8/20/2012	10,630.0	10,642.0	19646# 40/70,89235# 20/40 Ottw sd,22554# 20/40 CRC, Slick Water	2818.00		
5,247.4	6,183.5	90.6		Frac	8/20/2012	10,834.0	10,846.0	21612# 40/70,89665# 20/40 Ottw sd,21528# 20/40 CRC, Slick Water	2819.00		
6,592.2	6,169.4	90.6		Frac	8/20/2012	11,039.0	11,051.0	19312# 40/70,88396# 20/40 Ottw sd,24110# 20/40 CRC, Slick Water	2810.00		
6,640.4	6,168.9	90.6		Frac	8/20/2012	11,199.0	11,211.0	20364# 40/70,91519# 20/40 Ottw sd,22288# 20/40 CRC, Slick Water	2833.00		
6,741.1	6,167.9	90.3		Frac	8/20/2012	11,358.0	11,370.0	18056# 40/70,91158# 20/40 Ottw sd,19644# 20/40 CRC, Slick Water	2810.00		
6,855.0	6,167.7	90.0		Frac	8/20/2012	11,518.0	11,530.0	19750# 40/70,54420# 20/40 Ottw sd,22868# 20/40 CRC, Slick Water	2883.00		
6,957.3	6,168.5	89.9		Frac	8/20/2012	11,677.0	11,689.0	17861# 40/70,87541# 20/40 Ottw sd,18244# 20/40 CRC, Slick Water	2858.00		
7,162.1	6,168.1	89.6		Frac	8/20/2012	11,837.0	11,849.0	21290# 40/70,85740# 20/40 Ottw sd,20977# 20/40 CRC, Slick Water	2863.00		
7,355.0	6,169.1	91.0		Frac	8/20/2012	11,996.0	12,008.0	0# 40/70,0# 20/40 Ottw sd,0# 20/40 CRC, Slick Water	0.00		
7,469.2	6,167.0	90.4		Frac	8/20/2012	12,156.0	12,168.0	18995# 40/70,86740# 20/40 Ottw sd,23415# 20/40 CRC, Slick Water	3982.00		
7,571.8	6,165.4	91.0		Frac	8/20/2012	12,315.0	12,328.0	20066# 40/70,94938# 20/40 Ottw sd,22189# 20/40 CRC, Slick Water	3644.00		
7,764.4	6,162.9	90.8		Frac	8/20/2012	12,475.0	12,487.0	20064# 40/70,110235# 20/40 Ottw sd,21978# 20/40 CR, Slick Water	3672.00		
7,878.9	6,160.8	91.0		Frac	8/20/2012	12,590.0	12,602.0	38654# 40/70, 43728# 20/40 Ottawa sd, 4558 bbls , Slick Water	4558.00		
8,071.5	6,158.2	90.2		Tubing - Production set at 5,162.0ftKB on 9/4/2012 11:00							
8,276.2	6,156.4	89.8		Set Depth (ftKB)		Comment				Run Date	
8,390.7	6,157.3	89.6		5,162.0		Run tbg for jet pump operation				9/4/2012	
8,583.0	6,157.5	89.5		Item Des		OD (in)	ID (in)	Len (ft)	Top (ftKB)	Btm (ftKB)	
8,685.7	6,157.5	90.4		Tubing		2 7/8	2.441	5,125.68	7.8	5,133.5	
8,800.2	6,156.3	90.8		Tubing Sub		2 7/8	2.441	6.00	5,133.5	5,139.5	
8,993.1	6,153.0	89.7		Hydraulic Pump Cavity		2 7/8		3.00	5,139.5	5,142.5	
9,107.0	6,154.9	88.8		Tubing Sub		2 7/8	2.441	6.00	5,142.5	5,148.5	
9,209.3	6,156.0	90.1		Packer		6 1/2	2.441	7.50	5,148.5	5,156.0	
9,414.0	6,154.4	91.0		Tubing Sub		2 7/8	2.441	6.00	5,156.0	5,162.0	
9,607.0	6,155.6	90.0		<des> on <dtmrun>							
9,721.1	6,156.1	90.1		Rod Description				Run Date			
9,823.5	6,155.0	90.3		Item Des		OD (in)	Len (ft)	Top (ftKB)	Btm (ftKB)		
10,027.9	6,154.7	90.1									
10,220.8	6,152.8	90.4		Other String Components							
10,335.0	6,151.8	90.1		Item Des		OD (in)	Len (ft)	Top (ftKB)	Btm (ftKB)		
10,437.3	6,151.3	90.6									
10,629.9	6,154.1	87.8		Other In Hole							
10,744.1	6,158.4	88.1		Des		OD (in)	Run Date	Pull Date	Top (ftKB)	Btm (ftKB)	
10,846.5	6,160.8	89.4									
11,050.9	6,161.1	89.7		Bottom Hole Cores							
11,198.5	6,161.1	90.1		Date		Core #	Top (ftKB)	Btm (ftKB)	Recov (ft)		
11,255.6	6,160.9	90.0									
11,415.4	6,160.9	90.0									
11,529.5	6,160.9	90.1									
11,676.8	6,160.3	91.2									
11,746.4	6,158.2	92.3									
11,849.1	6,157.6	88.0									
12,007.9	6,159.1	90.3									
12,155.5	6,158.1	89.8									
12,212.6	6,157.9	90.4									
12,327.4	6,156.0	90.9									
12,475.1	6,157.4	90.5									
12,544.3	6,157.0	90.1									
12,602.0	6,157.5	89.2									
12,654.9	6,157.8	90.0									