

Well

Operator

Location

County

State

Field

Footages

CANYON CREEK 4-6-13

EnCana Oil & Gas (USA) Inc.

NWSE Section 13-T1N-R69W

BOULDER

Colorado

Wattenberg

2065' FSL & 2167' FEL

Spud Date:

06-05-12

TD Date:


06-09-12

Log Tops

Sussex	4608'
Niobrara	7494'
Codell	7899'
J Sand	8328'

Production Tubing
2-3/8" tubing, set 8311'

8464' — Driller's TD

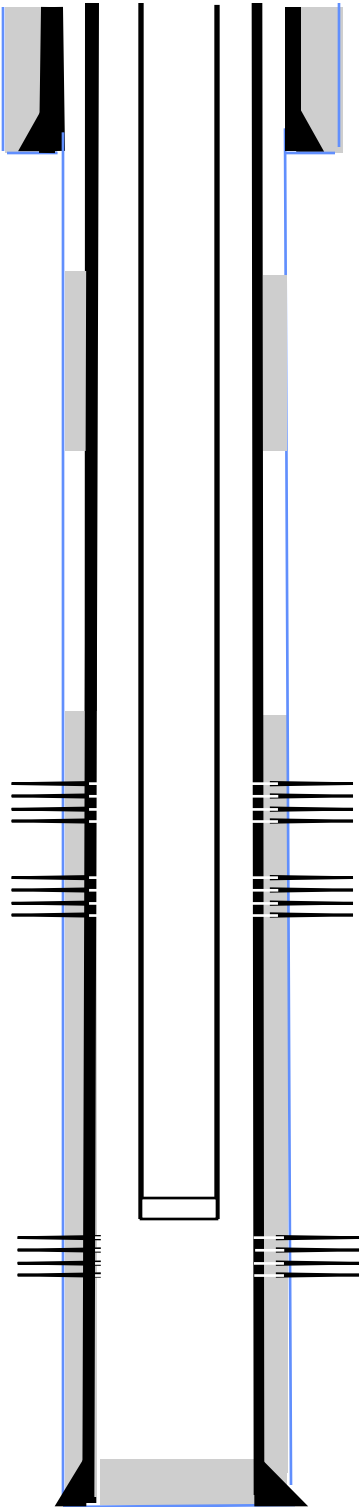

Surface Casing and Cement
8 5/8" , 24#, landed @ 840',cemented with 343 sxs

Main Hole
7-7/8" to TD

Production Casing and Cement
4-1/2", 11.6#, landed @ 8453',cemented with 680 sxs

CBP
Set @ 7430'. 08-07-12
Drilled out on 08-08-12

Perf'd the Niobrara from 7,499' – 7,503'; 7,653-7659' @ 4 spf
Frac'd the Niobrara 7,499' – 7,503'; 7,653-7659'. (40 holes), w/
108,853 gals 18 # pHaser Hybrid cross linked gel containing
252,950 # 30/50 sand. 07-31-12

CFP
Set @ 7440'. 07-30-12
Drilled out on 08-08-12

Perf'd the Codell from 7,900' – 7,914 @ 3 spf
Frac'd the Codell 7,900' – 7,914' (42 holes) w/ 86,060 gal 22#
pHaser Hybrid cross linked gel containing 252,360 # 30/50 sand.
07-30-12

CFP
Set @ 7730'. 07-30-12
Drilled out on 08-08-12

Perf'd the J Sand @ 8339' – 8355' @ 3 spf
Frac'd the J-Sand 8,339' – 8,355', (48 holes)w/ 59,907 gal 18 #
pHaser Hybrid cross linked gel containing 222,487 # 20/40 Sand.
07-30-12