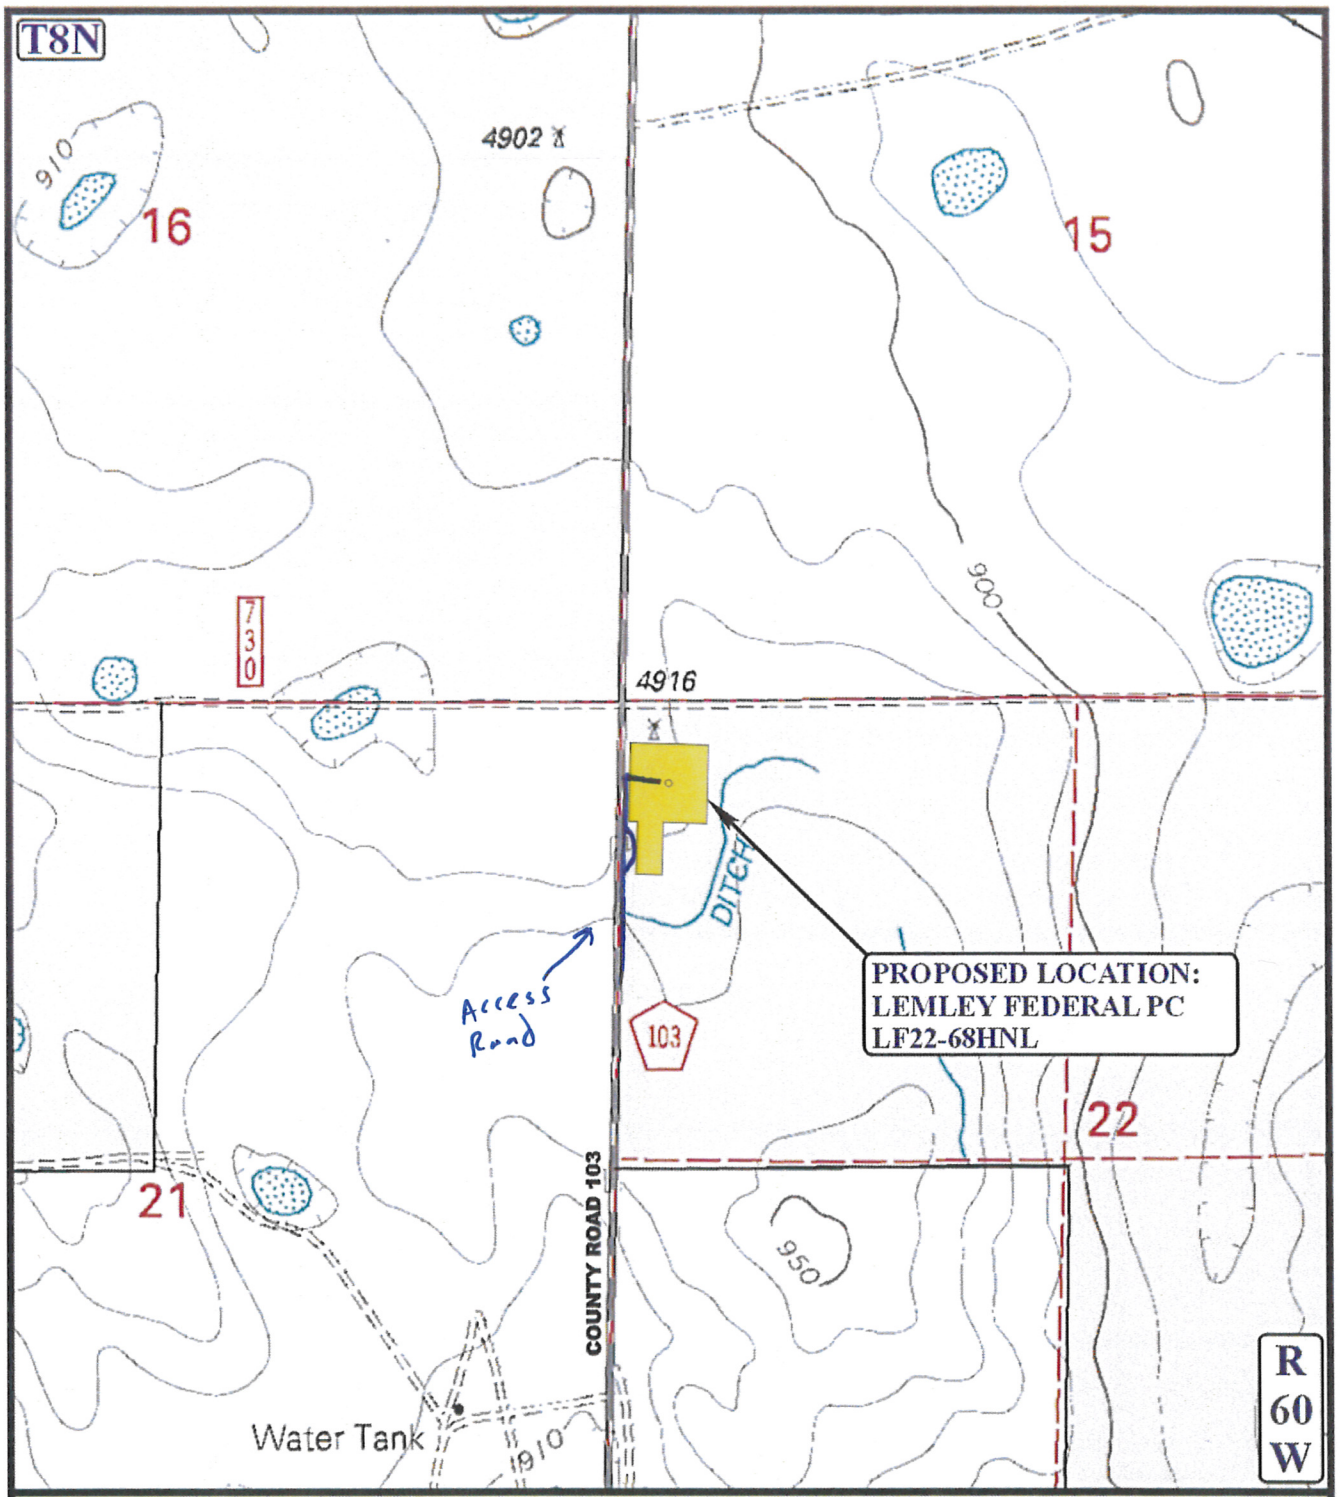

LEGEND:

NOBLE ENERGY, INC.

N

LEMLEY FEDERAL PC LF22-68HNL
SECTION 22, T8N, R60W, 6th P.M.

Uintah Engineering & Land Surveying
85 South 200 East Vernal, Utah 84078
(435) 789-1017 * FAX (435) 789-1813

ACCESS ROAD MAP	07 MONTH	30 DAY	12 YEAR	1 TOPO
SCALE: 1" = 1000'	DRAWN BY: J.L.H.	REVISED: 00-00-00		