

WPX Energy Rocky Mountain, LLC
BCU 411-31-198
Sulphur Creek Field
SHL 1632' FNL 512' FWL (SW/4 NW/4) BHL 839' FNL 643' FWL (NW/4 NW/4)
Section 31-T1N-R98W 6th PM
Garfield County, Colorado

Formation Tops
(Measured Depths)

Mesaverde @ 6370'

Cameo @ 8758'


Rollins @ 9339'

Cozzette @ 9424'

Corcoran @ 9604'

Sego @ 10018'

PBTD @ 10358'
TMD @ 10468'
TVD @ 10396'

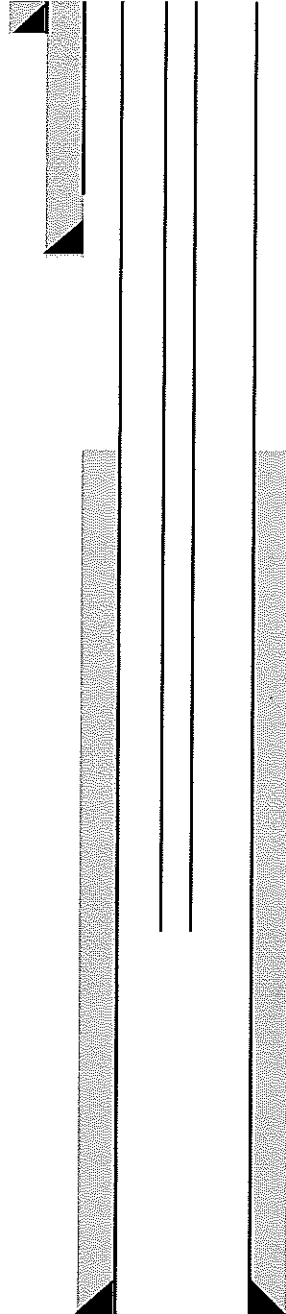

Conductor 30" Hole 18" casing/liner 80' W/135 sks cmt

Cmt @ Surface - (Cmt circ to surf during cmt job)

9 5/8" 32.3# ppf Csg. Set @ 3,188'
In 14 1/4" Hole W/1465 Sks. Cmt

Top Of Cement 5244'

7822-7958'	Mesaverde
8069-8264'	Mesaverde
8476-8684'	Mesaverde
8830-9001'	Mesaverde/Cameo
9057-9286'	Cameo
9621-9758'	Corcoran
9796-9947'	Corcoran

4-1/2", 11.6 ppf. Csg. Set @ 10458' W/ 1445 sks Cmt