Company: US ROCKIES REGION			**Site:** HSR-DREYER 5-5			
Project: COLORADO-ADAMS			**Common Well Name:** HSR-DREYER 5-5			
API No: 0500109223	Datum: RKB		Section: 5		Div of Quarter Section: SW	
Latitude: 39.997080°	Elevation: 5,065.0usft		Township: 1	S	Div of Section: NW	
Longitude: -104.693200°	Water Depth: 5,055.0usft		Range: 65	W		

Casing Information	Casing Size & Weight	Cement Fluid (sacks)	Cement Depths (ft)	Schematic (1/4/2013)	Hole Size (in)	MD / PBMD (usft)	Perforation Intervals (usft)
SURFACE CASING - Set @ 444.0usft	8.625in, 4.500in, 11.60ppf	, 3% CACL2 & 1/4#/SX FLOCEL, 300	50 (TOC) 400 (TOC) 444	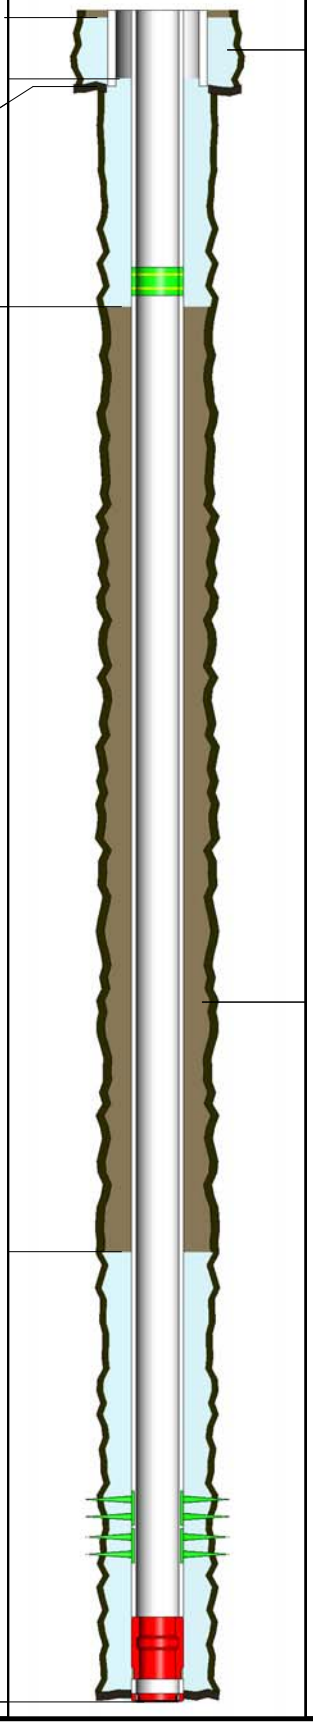	12.250		
PRODUCTION CASING - Set @ 8, 252.0usft	4.500in, 11.60ppf	, 10% SALT, 35% SSA, 290 520	1544 6930 (TOC)		7.875		7,956 - 7,970 - J SAND 7,984 - 7,986 - J SAND
	4.500in, 11.60ppf		8252			MD: 8,246 PBMD: 8,115	