

Well

Operator

Location

County

State

Field

Footages

MAIER 31-28

EnCana Oil & Gas (USA) Inc.

SWNE SEC. 28-T2N-R66W

WELD

Colorado

Wattenberg

1759' FNL & 2190' FEL

Spud Date:

07-06-12

TD Date:

07-11-12

Log Tops

Sussex

4690'

Niobrara

7298'

Codell


7589'

J Sand

8035'

Production Tubing

2-3/8" tubing, set @ 8045'

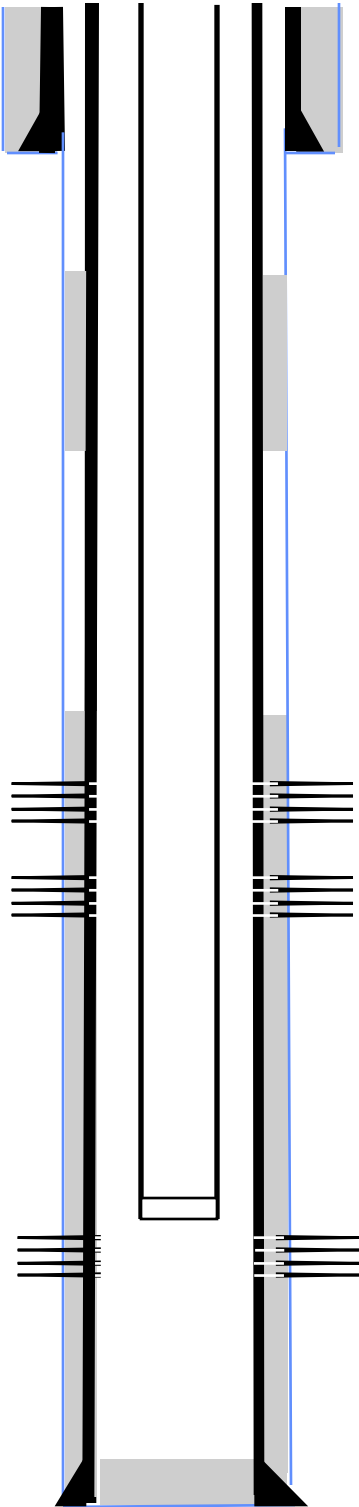

Surface Casing and Cement

8 5/8" , landed @ 917',cemented with 350 sxs

Main Hole

7-7/8" to TD

Production Casing and Cement

4-1/2", landed @ 8156',cemented with 675 sxs

140 sxs

CBP

Set @ 7340' . 08-18-12

Drilled out on 08-21-12

Perf'd the Niobrara 7,375' – 7,387' @ 4 spf

Frac'd the Niobrara 7,375' – 7,387' (48 holes), w/ 97,062 gals 18 #

Vistar Hybrid crosslinked gel containing 253,040 # 30/50 sand. 07-27-12

CFP

Set @ 7440'. 07-27-12

Drilled out on 08-21-12

Perf'd the Codell 7,590' – 7,604' @ 3 spf

Frac'd the Codell 7,590' – 7,604' (42 holes) w/ 88,368 gal 22#

Vistar Hybrid cross linked gel containing 250,440 # 30/50 sand. 07-27-12

CFP

Set @7650'. 07-27-12

Drilled out on 08-21-12

Perf'd the J Sand 8,055' – 8,080' , @ 2 spf

Frac'd the J-Sand 8,055' – 8,080', (50 holes)w/ 63,840 gal 18 #

Vistar Hybrid cross linked gel containing 250,120 # 20/40 Sand. 07-27-12

8180'

—

Driller's TD