

WPX Energy Rocky Mountain, LLC
RGU 413-25-198
Sulphur Creek Field
SHL 362' FSL 1410' FWL (SE/4 SW/4) BHL 1936' FSL 608 FEL (NW/4 SW/4)
Section 25-T1S-R98W 6th PM
Garfield County, Colorado

Formation Tops
(Measured Depths)

Mesaverde @ 8015'

Cameo @ 11077'

Rollins @ 11661'

Cozzette @ 11793'


Corcoran @ 12018'

Sego @ 12402'

PBTD @ 12839'

TMD @ 12878'

TVD @ 12628'

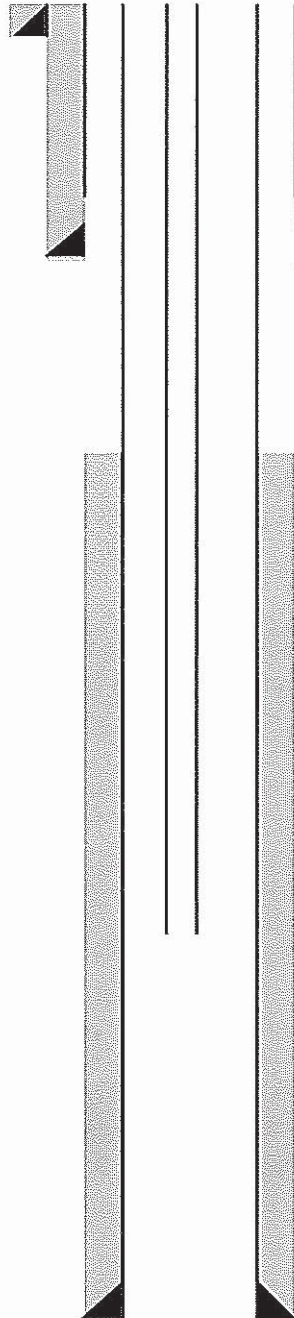

Conductor 30" Hole 18" casing/liner 80' W/135 sks cmt

Cmt @ Surface - (Cmt circ to surf during cmt job)

9 5/8" 32.3# ppf Csg. Set @ 3983'
In 14 1/4" Hole W/2055 Sks. Cmt

Top Of Cement 4928'

10056-10214' Mesaverde
10289-10505' Mesaverde
10608-10853' Mesaverde
10992-11069' Mesaverde/Cameo
11139-11295' Cameo
11382-11577' Cameo
12085-12167' Corcoran
12260-12388' Corcoran
12412-12689' Sego

4-1/2", 11.6 ppf. Csg. Set @ 12871' W/ 1745 sks Cmt