

WELL LOCATION CERTIFICATE: BUSYGULLY 13-54-12-3

SECTION 12, TOWNSHIP 13 SOUTH, RANGE 54 WEST, 6TH P.M.

N 88°49'30" E 5260.67'

NE SEC. 12
2 1/2 ALUM. CAP
PLS 36073

NW SEC. 12
2 1/2 ALUM. CAP
PLS 36073

SH
BUSYGULLY
13-54-12-3
EL. 4843'

RIG SKID
P.M.

(BASIS OF BEARINGS) SEE NOTE 3
N 01°24'42" W 5303.23'

S 01°25'26" E 5322.95'

12

SURFACE LOCATION

GROUND ELEVATION= 4843'

NAD83

LATITUDE= 38.933878° 38.933701 P.M.

LONGITUDE= 103.399755° -103.399715

PDOP= 1.24

GPS OPERATOR: ALAN HNIZDO

NOTES:

LAND SURFACE USE-RANGELAND
SEE ATTACHED MAP FOR ADDITIONAL
IMPROVEMENTS WITHIN 400'.

SW SEC. 12
2 1/2 ALUM. CAP
PLS 36073

S 89°02'23" W 5261.92'

SE SEC. 12
2 1/2 ALUM. CAP
PLS 36073

WELL BUSYGULLY 13-54-12-3 TO BE LOCATED 1072' FNL AND 1359' FWL

1063' 1371' P.M.

LEGEND


- = EXISTING MONUMENT
 = BOTTOM HOLE
 BH = BOTTOM HOLE
 = PROPOSED WELL
 = EXISTING WELL

NOTES:

- THIS FIELD SURVEY CONFORMS TO THE MINIMUM STANDARDS SET BY THE C.O.G.C.C., RULE NO. 215
- HORIZONTAL POSITIONS AND ORTHOMETRIC ELEVATIONS SHOWN AT THE WELL HEAD, ARE BASED ON GPS-RTK POSITIONS DERIVED FROM MINIMUM 2-HOUR STATIC OBSERVATIONS CORRECTED BY THE NATIONAL GEODETIC SURVEY ONLINE POSITIONING USER SERVICE, O.P.U.S. DATUM: HORIZONTAL = NAD83/2007, VERTICAL = NAVD88
- THE BASIS OF BEARINGS ARE STATE PLANE COORDINATE SYSTEM GRID BEARINGS SHOWN HEREON BETWEEN THE DESCRIBED MONUMENTS SHOWN HEREON.
- GRID DISTANCES ARE SHOWN, AS MEASURED IN THE FIELD, WITH TIES TO WELLS MEASURED PERPENDICULAR TO SECTION LINES.

I, MARK A. HALL, A LICENSED PROFESSIONAL LAND SURVEYOR IN THE STATE OF COLORADO DO HEREBY CERTIFY TO PINE RIDGE OIL & GAS, THAT THE SURVEY AND WELL LOCATION CERTIFICATE SHOWN HEREON WERE DONE BY ME OR UNDER MY DIRECT SUPERVISION AND THAT THE DRAWING SHOWN HEREON ACCURATELY DEPICTS THE PROPOSED LOCATION OF THE WELL. THIS CERTIFICATE DOES NOT REPRESENT A LAND SURVEY PLAT OR IMPROVEMENT SURVEY PLAT AS DEFINED BY C.R.S. 38-61-102 AND CANNOT BE RELIED UPON TO DETERMINE OWNERSHIP.

MARK A. HALL, PLS 36073
COLORADO LICENSED PROFESSIONAL LAND SURVEYOR
FOR AND ON BEHALF OF P.F.S., LLC

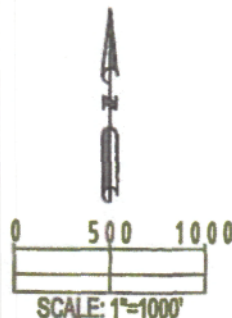

PREPARED BY:



FIELD DATE:

10-17-12

DRAWING DATE:

10-18-12

BY:

JAH

CHECKED:

MLP

SURFACE LOCATION:

NE 1/4 NW 1/4,
SEC. 12, T13S, R54W, 6TH P.M.

LINCOLN COUNTY, COLORADO

NOTICE: ACCORDING TO COLORADO LAW YOU MUST COMMENCE ANY LEGAL ACTION BASED UPON ANY DEFECT IN THIS SURVEY WITHIN THREE YEARS AFTER YOU FIRST DISCOVER SUCH DEFECT. IN NO EVENT MAY ANY ACTION BASED UPON ANY DEFECT IN THIS SURVEY BE COMMENCED MORE THAN TEN YEARS FROM THIS SAID DATE OF THIS CERTIFICATION SHOWN HEREON.