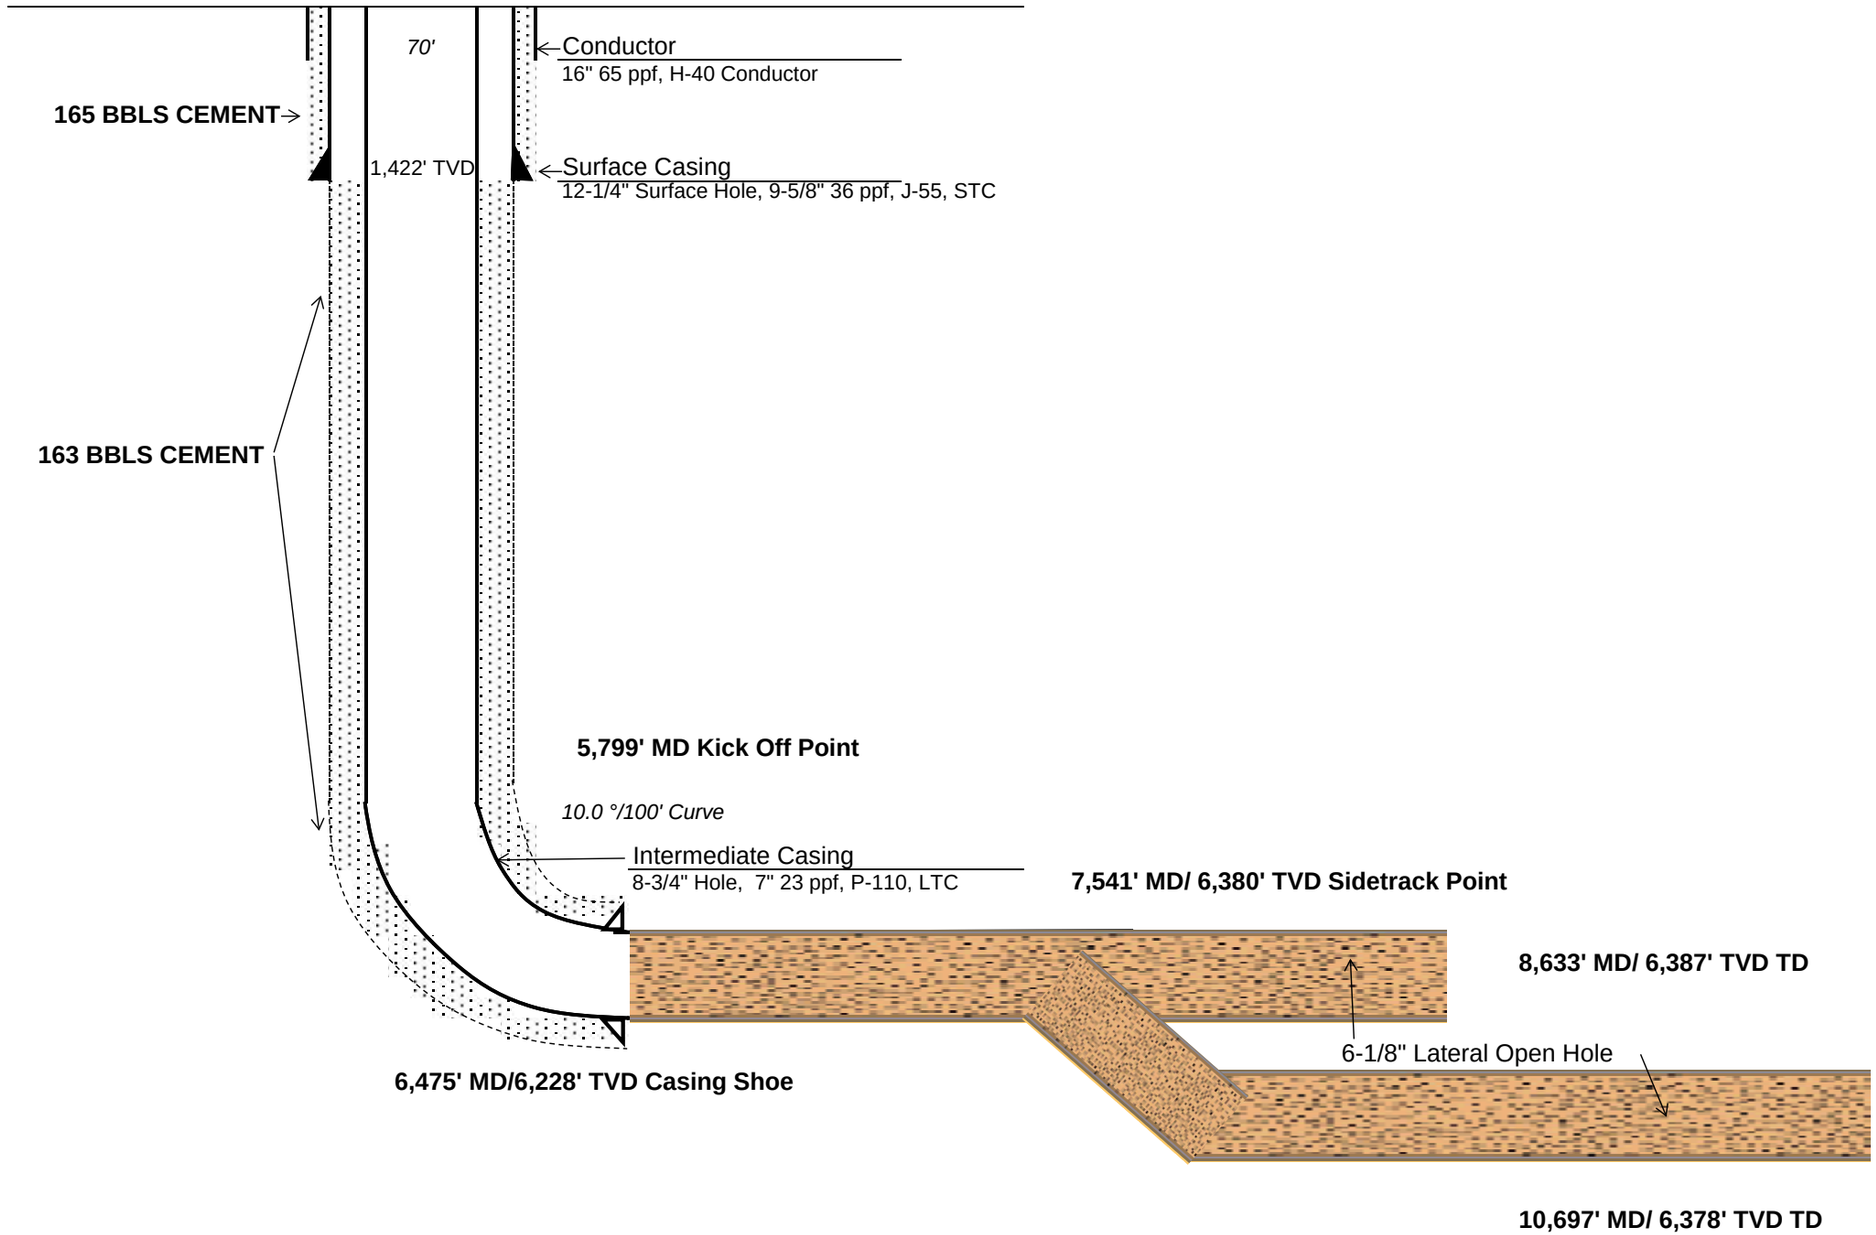SLICK ROCK 2-17-11-7-60 SIDE TRACK WELLBORE