

WPX Energy Rocky Mtn LLC

FINAL

RWF # 313-35


API #05-045-20492-00

2068' FNL x 530' FWL - (SWNW) - SHL

2473' FSL x 457' FWL - (NWSW) - BHL

Sec. 35-T6S-R94W

Garfield County, Colorado

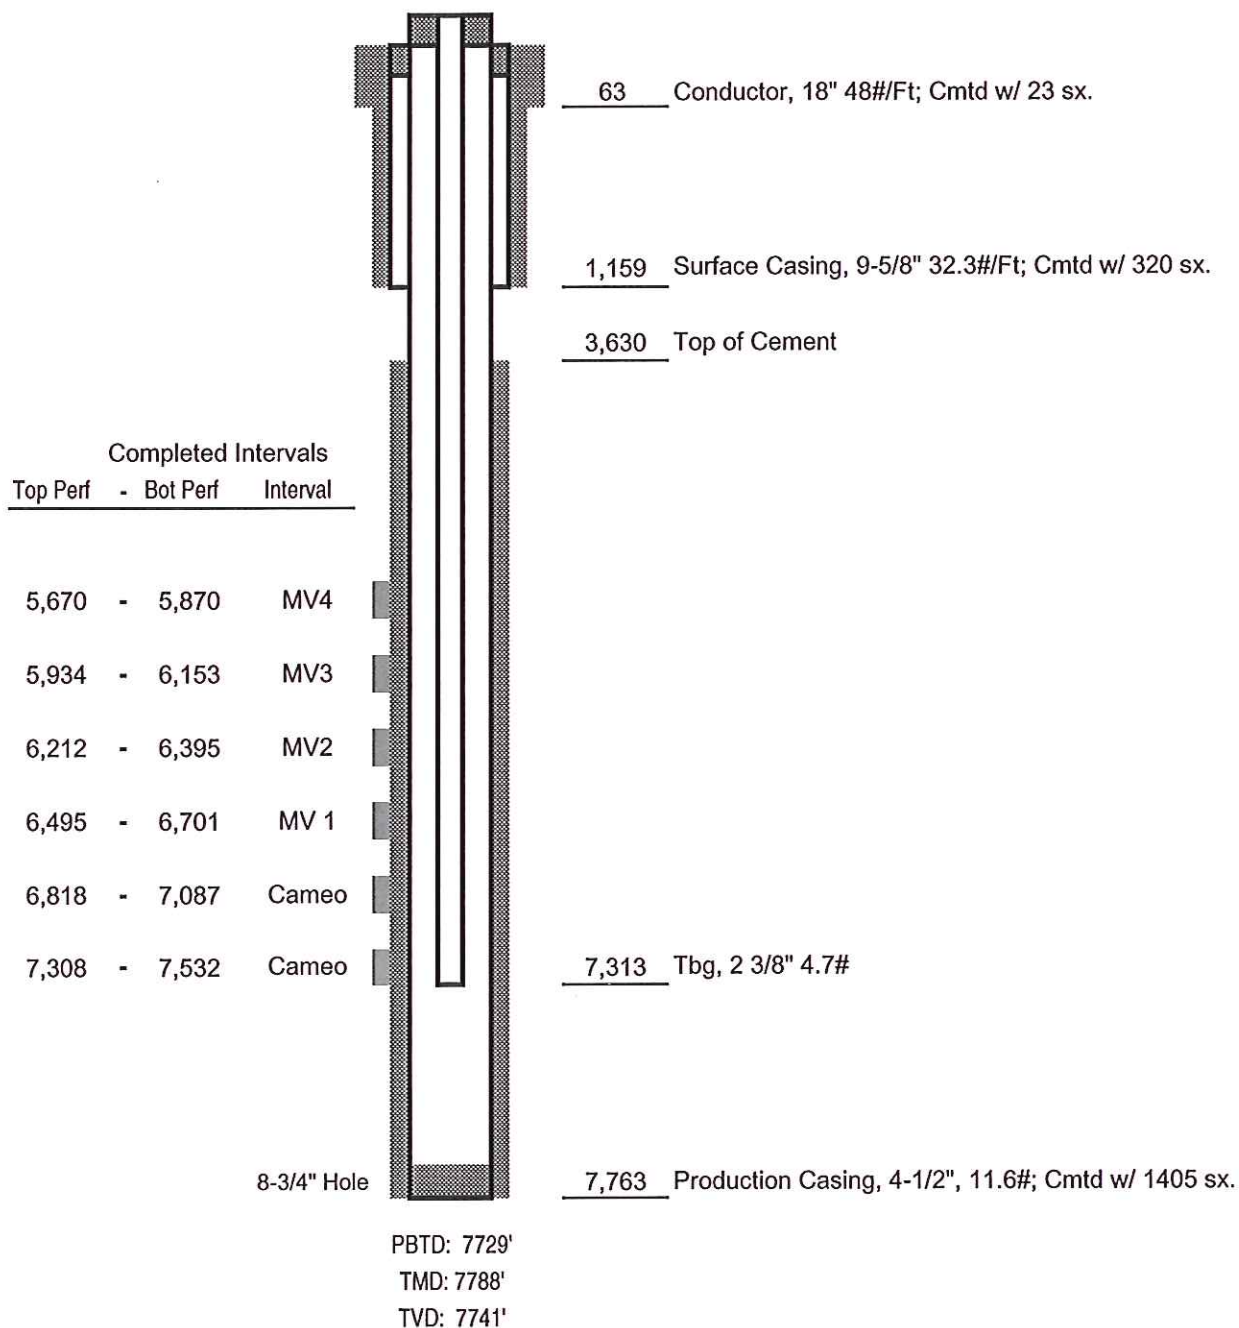

Not to Scale