




Lease Name: Olson 3CD

Legals: NENE – Sec. 3, T3N, R68W

County: Weld County, Colorado

API#: 05-123-35920

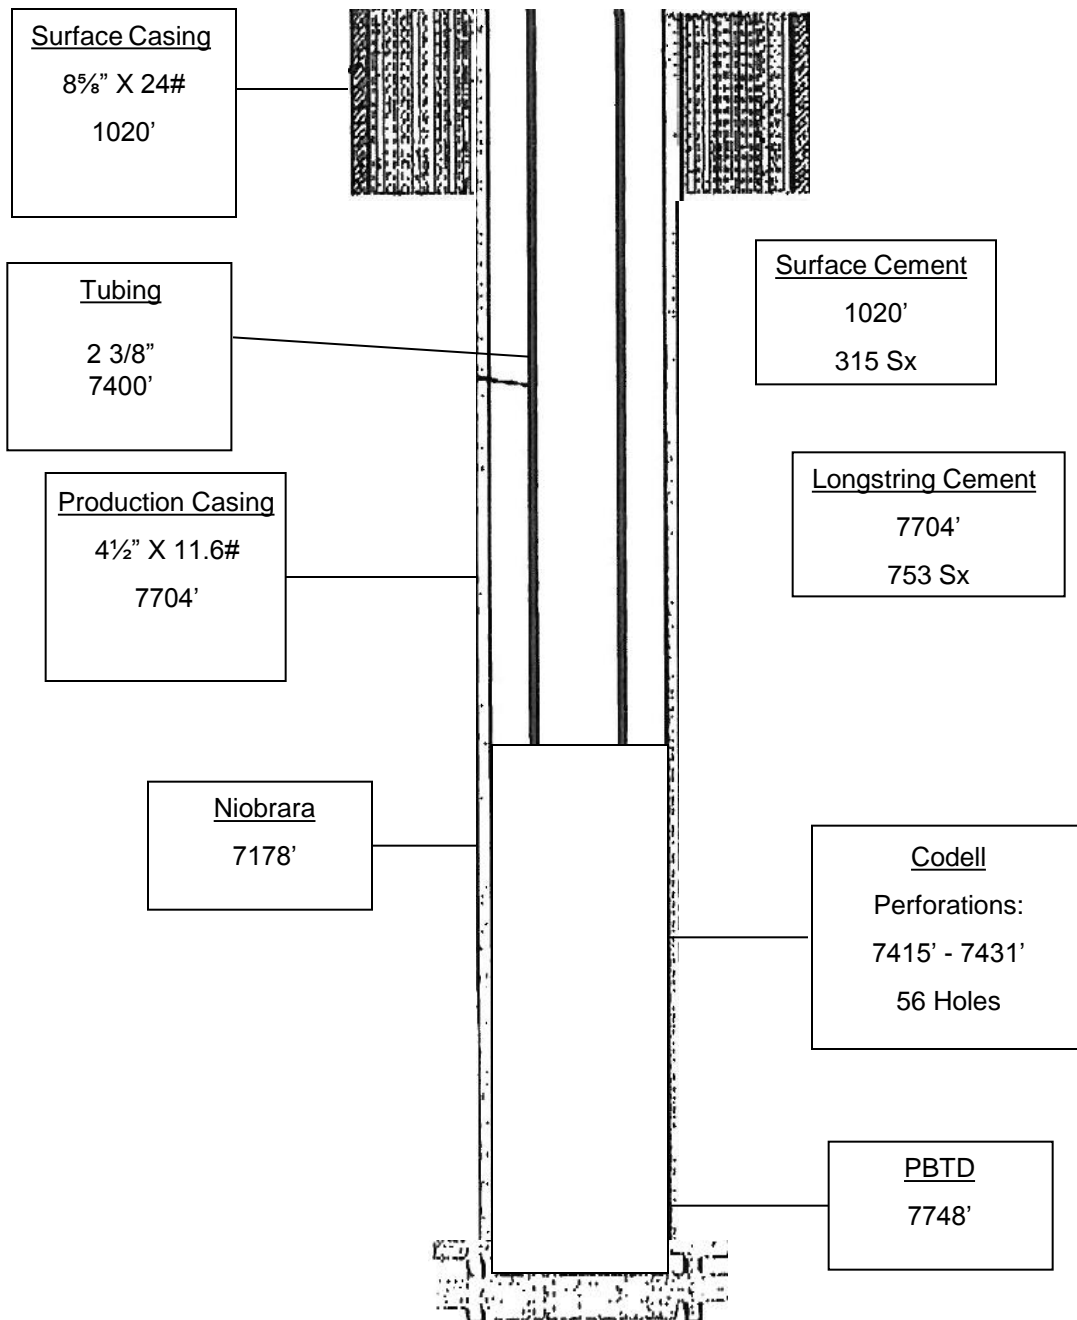

Wellbore Diagram