

WPX Energy Rocky Mtn LLC

FINAL

**RWF # 323-35**


API #05-045-20454-00

2053' FNL x 532' FWL - (SWNW) - SHL

2353' FSL x 1914' FWL - (NESW) - BHL

Sec. 35-T6S-R94W

Garfield County, Colorado

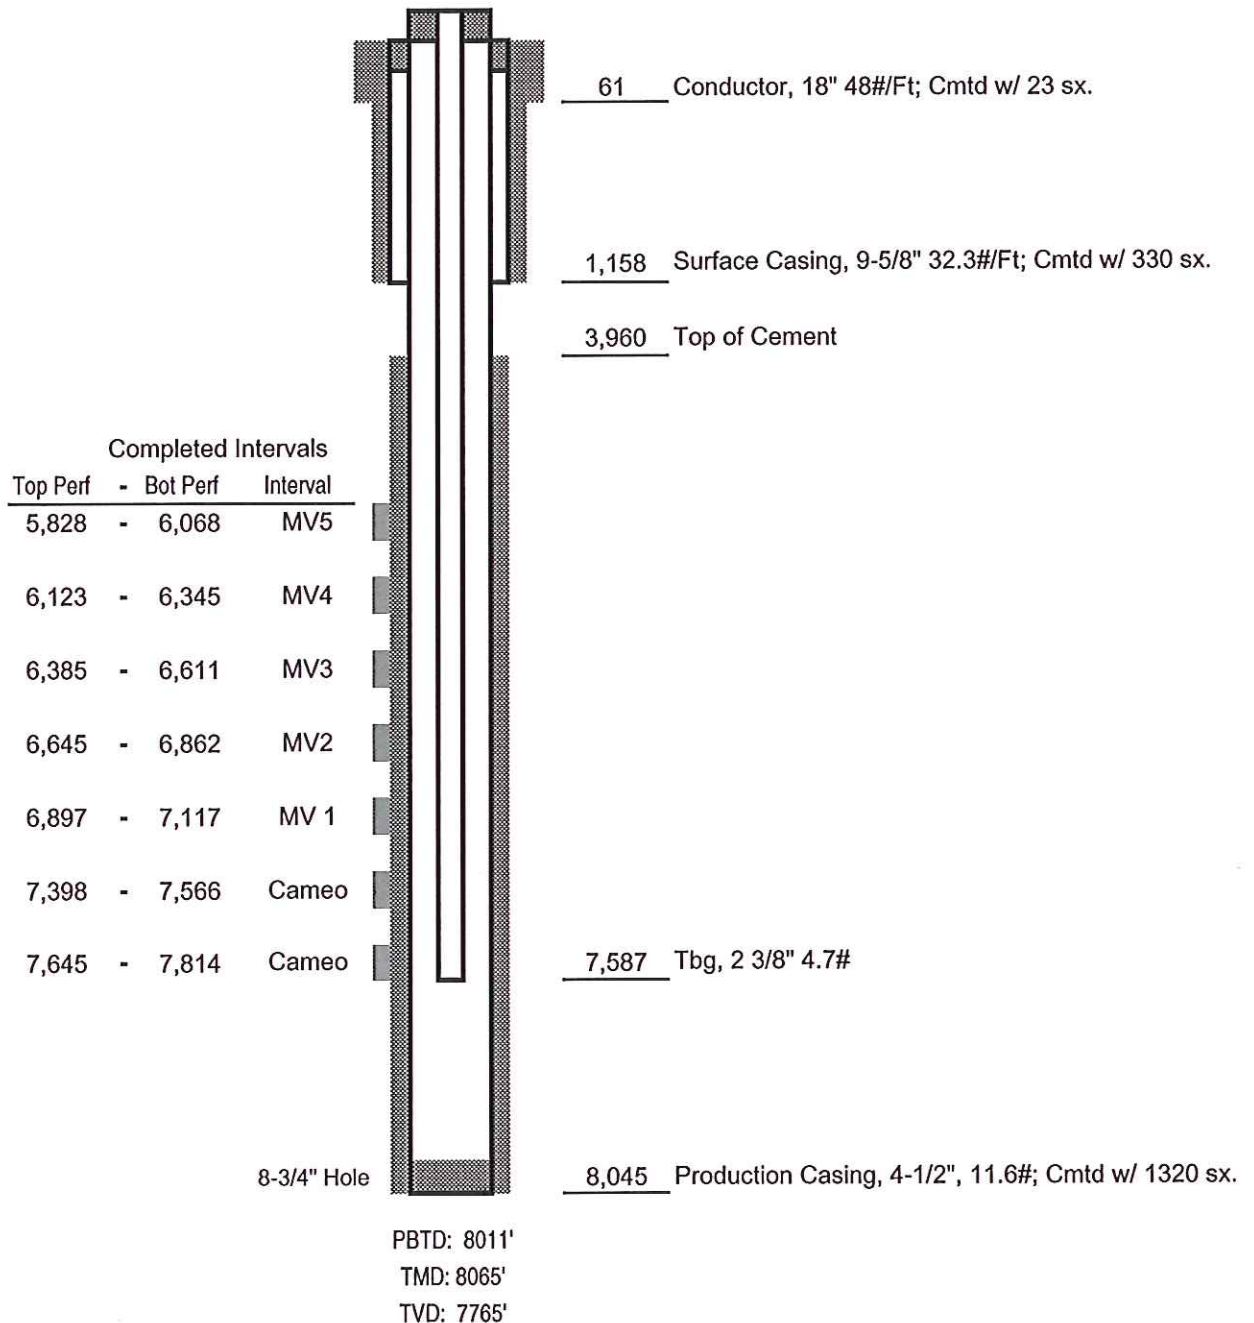

Not to Scale