


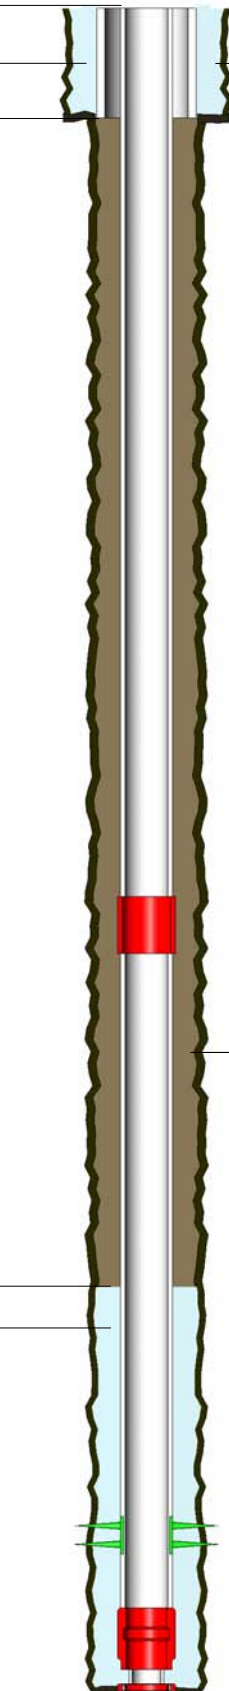

Company: US ROCKIES REGION		Site: MILLER 8-29 PAD	
Project: COLORADO-WELD		Common Well Name: MILLER UPRR 42-29 #2	
API No: 0512313100	Datum: RKB	Section: 29	Div of Quarter Section: SE
Latitude: 40.197690°	Elevation: 4,925.0usft	Township: 3 N	Div of Section: NE
Longitude: -104.793000°	Water Depth: 4,914.0usft	Range: 66 W	

Casing Information	Casing Size & Weight	Cement Fluid (sacks)	Cement Depths (ft)	Schematic (1/11/2013)	Hole Size (in)	MD / PBMD (usft)	Perforation Intervals (usft)
SURFACE CASING - Set @ 591.0usft	8.625in, 24.00ppf	, , 150 , , 100	10 (TOC) 300 591		12.250		
PRODUCTION CASING - Set @ 7,516.0usft	4.500in, 11.60ppf		6460 (TOC) 6680		7.875		
	4.500in, 11.60ppf	TAIL 50/50 POZ-MIX, 175	7516			MD: 7,516 PBMD: 7,501	7,136 - 7,136 - NIOBRARA 7,149 - 7,149 - NIOBRARA 7,173 - 7,173 - NIOBRARA 7,182 - 7,182 - NIOBRARA 7,184 - 7,184 - NIOBRARA 7,186 - 7,186 - NIOBRARA 7,401 - 7,409 - CODELL 7,400 - 7,412 - CODELL